

RECORDED

MAR 07 2000

ALLEGAN COUNTY REMONUMENTATION PROGRAM
LAND CORNER RECORDATION CERTIFICATE
Filing Requirement of Act 74, Mich. P.A. 1970

FILED

00 FEB -1 AM 8:39

For corners in SECTION


ALLEGAN Located In: FILLMORE Corner Code #
(County) (Township)

1. Public Land Survey T 4N R 15W A-9
T 4N R 16W ✓ M-9 LAKEVIEW TWP.
T ___ R ___ N.W. CORNER
T ___ R ___ SECTION 30
2. Property Controlling S ___ T ___ R ___ COMMON
in Section S ___ T ___ R ___ CORNER
3. Miscellaneous S ___ T ___ R ___
Property in Sec. S ___ T ___ R ___

Jayne A. [Signature]
REGISTER OF DEEDS
ALLEGAN COUNTY, MICH.
Register of Deeds Stamp & File Number

4. Lot No. _____, Recorded Plat _____
5. Private Claims _____

I, Robert E. Lemke, surveyor, in a field survey on February 17, 1999 do hereby state that under requirements of P.A. 74, Michigan P.A. of 1970, the corner points mentioned in lines 1 and 2 above were in conformance with regulations and rules therefore as required in the current manual of survey instructions of the United States Department of the Interior, Bureau of Land Management or by a decree of a Court of Law and /or that the corner points mentioned in lines 3, 4 and 5 above were in conformance with the rules of the Michigan Board of Land Surveyors or by a Decree of a Court of Law; established, re-established, monumented, recovered, found as expressed below:

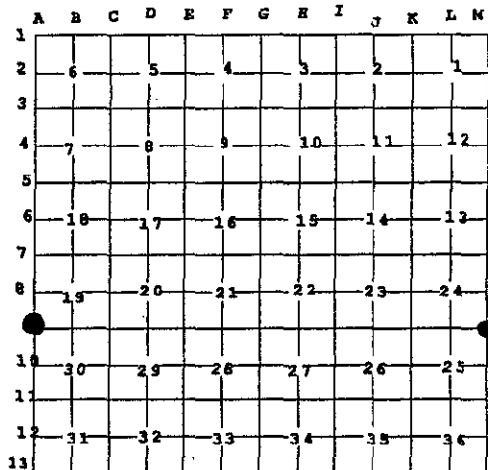

NOTE: Not more than 2 corners, all in the same town and range, may be recorded on this certificate.

A. Description of original monument and accessories and/or subsequent restoration:

SEE BACK OF SHEET FOR CORNER HISTORY

B. Description of corner evidence found and/or method applied in restoring or reestablishing corner:

A-9
FOUND 1/2" IRON BAR IN MONUMENT BOX.

N.W. CORNER OF BRICK HOUSE S 62° E 135.25'
CENTER OF WOOD POWER POLE (DID NOT FIND NAIL) S 46° W 99.0'
NAIL & TAG (RLS #14091) ON N.E. SIDE OF WOOD POWER POLE N 30° W 105.70'

MEASUREMENTS A-9 TO B-9 MEASUREMENTS A-9 TO A-10 MEASUREMENTS A-9 TO A-8
SDI = 3007.64 SDI= 2640.86 SDI=2647.53'
GLO =3008.94 WIGHTMAN=2640.82
WIGHTMAN =3007.52

(DISTANCE TRAVERSED=5288')

THIS CORNER IS ACCEPTED AS A COMMON CORNER AND IS ACCEPTED AS A CAREFUL AND FAITHFUL PERPETUATION OF THE POSITION OF THE ORIGINAL CORNER. SET 3/4" X 24" ALLEGAN COUNTY REMONUMENTATION IRON AND CAP #23520 IN MONUMENT BOX

PEER GROUP APPROVED AUGUST 10, 1999.

APPROVED REMONUMENTATION CORNER
P.A. 345 OF 1990
ALLEGAN COUNTY
DATE APPROVED AUG. 10, 1999.
COUNTY REP. *[Signature]*

C. Description of monument for corner and accessories established to perpetuate locating the position of the corner:


A-9
SET 3/4" X 24" ALLEGAN COUNTY REMONUMENTATION IRON AND CAP #23520 IN MONUMENT BOX.

SET NAIL WITH ALLEGAN CO. REMON. TAG ON N.E. SIDE OF WOOD POWER POLE 12" ABOVE GROUND N 30° W 105.66'
SET NAIL WITH ALLEGAN CO. REMON. TAG ON N.W. SIDE OF WOOD POWER POLE 12" ABOVE GROUND N 28° E 93.47'
SET NAIL WITH ALLEGAN CO. REMON. TAG ON NORTH SIDE OF 24" MAPLE TREE 24" ABOVE GROUND S 78° E 158.37
SET NAIL WITH ALLEGAN CO. REMON. TAG ON N.W. SIDE OF WOOD POWER POLE 36" ABOVE GROUND S 46° W 99.45'
N.W. CORNER OF BRICK HOUSE S 62° E 135.25'

Signed by Robert E. Lemke
For SDI CONSULTANTS, LTD

Date 12-30-1999

Surveyor's Michigan License No. 40160

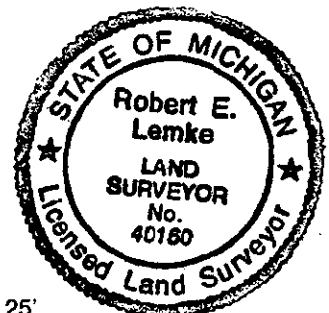

RE...

WAR 07 2000

SECTION

T.4N., R.15W. A-9 CONTINUED
FILLMORE TWP

G.L.O.

WEST BETWEEN SECTIONS 19 & 30

85.59 CHAINS INTERSECT WEST BOUNDARY AT POST. (COMMON CORNER)

DECEMBER 15, 1831

TIES FROM THE N.E. CORNER OF SECTION 25, T. 4 N., R 16 W.

12" HEMLOCK N 19° W	4 LINKS
18" HEMLOCK S 31° W	54 LINKS

L.C.R.C. RECORDED LIBER 3, PAGE 194.

JULY 26, 1978 BY DAVID GREER(#16042)

M-9 OF TOWN 4 NORTH, RANGE 16 WEST

PART B. STATES THAT A 1/2" IRON WAS SET BY MEASUREMENTS FROM THE RECORDS OF THE ALLEGAN CO. SURVEYOR.

PART C.

M-9 1/2" STEEL ROD

NW CORNER OF HOUSE	S78°E	135.31
--------------------	-------	--------

POWER POLE	S40°W	99.44
------------	-------	-------

POWER POLE	N45°W	105.67
------------	-------	--------

WIGHTMAN MOORED, INC. BOUNDARY SURVEY FIELD NOTES, JULY 10, 1991

FOUND 1/2" IRON IN BOX

A-9 TO B-9 DISTANCE = 3007.52'

WIGHTMAN MOORED, INC. BOUNDARY SURVEY, 7-21-92

A-10 TO A-9 = N00°11'40"E 2640.82

LIBER 007 PAGE 241