

SURVEY &
REMONUMENTATION

MAR 16 1999

SECTION

LAND CORNER RECORDATION CERTIFICATE
Filing Requirement of Act 74, Mich. P.A. 1970
Chippewa County Remonumentation Corner

For corners in

Chippewa County	Located in:	Corner Code #
1. Public Land Survey	T44N R2W	C-3
	T R	
	T R	
	T R	
2. Property Controlling in Section	S T R	
	S T R	
3. Miscellaneous Property in Sec.	S T R	
	S T R	
4. Lot No. , Recorded Plat		
5. Private Claims		

\$7.00 LAND CORNER
 \$2.00 MSSR
 5 MAR 1999 10:49:14 AM Receipt #14013
 RECEIVED FOR RECORD
 CHIPPEWA COUNTY - STATE OF MICHIGAN
 SHARON H. KENNEDY, REGISTER OF DEEDS

BOOK 10 PAGE 395
 Register of Deeds Stamp & File Number

I, Keith R. Waters, in a field survey on January 22, 1998, do hereby state that under requirements of P.A. 74, Michigan P.A. of 1970, the corner points mentioned in lines 1 and 2 above were in conformance with regulations and rules therefore as required in the current manual of survey instructions of the United States Department of the Interior, Bureau of Land Management or by a decree of a Court of Law and/or that the corner points mentioned in lines 3, 4 and 5 above were in conformance with the rules of the Michigan Board of Land Surveyors or by a Decree of a Court of Law; established, re-established, monumented, recovered, found as expressed below:

NOTE: Not more than 2 corners, all in the same town and range, may be recorded on this certificate.

A. Description of original monument and accessories and/or subsequent restoration:

C-3 Corner Common to Sections 5, 6, 7, & 8, Town 44 North, Range 2 West

- 1845 - Original corner (10" Cedar) established by James Mullett.
- 1896 - Chippewa County Surveyor Frederick H. Brown, RLS 944, notes indicate that this corner was established by Carleton for the survey of the Village of Rudyard.
- Circa 1930's - Chippewa County Surveyor corner tie book shows corner with various witnesses.
- 1959 - Liber 2, page 252, Chippewa County corner records. Michigan State Highway Department found a 1/2" iron pin in a monument box. No witnesses.
- 1990 - LCRC, liber 9, page 143, Chippewa County corner records. Larry R. Rogers, P.S. 29251, found a boat spike in a monument box at the intersection of Old US- 2 and M-48. Corner works well with others in area. Replaced the boat spike with a 1/2" iron and cap. Witnesses:
 Existing M.S.H.D. tag in Power Pole (5/40/TS), N67°W 57.07'
 Southeast corner of Concrete Headwall, N14°E 75.34'
 Power Pole, S56°E 66.83'
 Northeast corner of Brick Post Office, S50°W 132.97'


B. Description of corner evidence found and/or method applied in restoring or reestablishing corner:

This corner is being perpetuated as part of the Chippewa County Remonumentation Program. Found a 1/2" iron with cap #29251 in a monument box and all witness objects as called for in the above mentioned 1990 LCRC.

C. Description of monument for corner and accessories established to perpetuate locating the position of the corner:

Found a 1/2" iron with plastic cap #29251 in a monument box at the corner location, which falls in the intersection of Mackinac Trail and Highway M-48 to the east. Witnesses:

- Nail and M.S.H.D. witness tag in Power Pole (5/L10/T5), N67°W 57.07'
- Southeast corner of Concrete Headwall, N14°E 75.34'
- Nail and tag #29251 in side of Power Pole (E/14/05), S56°E 66.83'
- Northeast corner of Brick Post Office Building, S50°W 132.97'

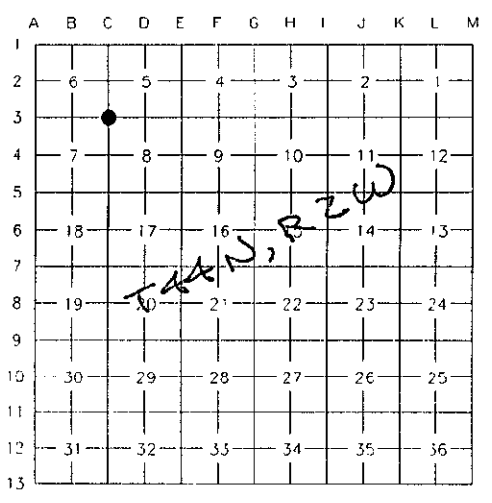

Signed by Keith R. Waters

Date 12-30-98

Surveyor's Michigan License No. 33142