

MAR 16 1999

SECTION

LAND CORNER RECORDATION CERTIFICATE
Filing Requirement of Act 74, Mich. P.A. 1970
Chippewa County Remonumentation Corner

For corners in

Table with columns: Chippewa County, Located in:, Corner Code #. Rows include Public Land Survey, Property Controlling in Section, Miscellaneous Property in Sec., Lot No., and Private Claims.

\$7.00 LAND CORNER
\$2.00 MSSR
5 MAR 1999 10:53:17 AM Receipt #14013
RECEIVED FOR RECORD
CHIPPWEA COUNTY - STATE OF MICHIGAN
SHARON H. KENNEDY, REGISTER OF DEEDS

BOOK 10 PAGE 399
Register of Deeds Stamp & File Number

I, Keith R. Waters, in a field survey on November 25, 1998, do hereby state that under requirements of P.A. 74, Michigan P.A. of 1970, the corner points mentioned in lines 1 and 2 above were in conformance with regulations and rules therefore as required in the current manual of survey instructions of the United States Department of the Interior, Bureau of Land Management or by a decree of a Court of Law and /or that the corner points mentioned in lines 3, 4 and 5 above were in conformance with the rules of the Michigan Board of Land Surveyors or by a Decree of a Court of Law; established, re-established, monumented, recovered, found as expressed below:

NOTE: Not more than 2 corners, all in the same town and range, may be recorded on this certificate.

A. Description of original monument and accessories and/or subsequent restoration:

C-9 Corner Common to Sections 19, 20, 29, & 30, Town 44 North, Range 2 West

- 1845 - Original corner established by James Mullett. Witnesses: Birch 10, N62°E 18 links - Sugar 12, S75°W 22 links.
1897 - Chippewa County Surveyor Frederick H. Brown, RLS 944, notes state "located too far east by County Road survey, could not change and put in large cedar post."
Circa 1930's - Chippewa County Surveyor corner tie book shows corner along with several witnesses.
1948 - Chippewa County Surveyor Rudolph Larsen, RLS 3644, notes show corner with several witnesses.
1959 - Liber 2, page 252, Chippewa County corner records. Michigan State Highway Department, found concrete monument.
1983 - LCRC, liber 6, page 130, Chippewa County corner records. William L. Karr, P.S. 27450, found no evidence of the Highway Department corner.



B. Description of corner evidence found and/or method applied in restoring or reestablishing corner:

This corner is being perpetuated as part of the Chippewa County Remonumentation Program. Found the two spruce bearing trees as called for in the 1983 LCRC, the power pole is gone. Found the 1 1/2" iron pipe lying on the side of the road, it appears to have been removed by road construction. Reset the corner using the bearing trees and record measurements from adjacent found corners.

C. Description of monument for corner and accessories established to perpetuate locating the position of the corner:

Placed a 3/4" x 24" rebar with a plastic Chippewa County Remonumentation cap at the corner location, which falls in the approximate centerline of a north-south gravel road, 121± south of the centerline of M-48. Witnesses:

- Nail and plastic witness tag #33142 in side of Power Pole (RU2/6), S80°W 32.27'
Nail and plastic witness tag #33142 in side of 14" Jack Pine (in cemetery), S66°W 148.70'
Nail and plastic witness tag #33142 in side of blazed 12" Spruce, S21°W 98.82'
Nail and plastic witness tag #33142 in side of blazed 12" Spruce, S70°E 67.87'

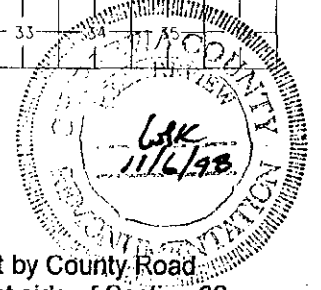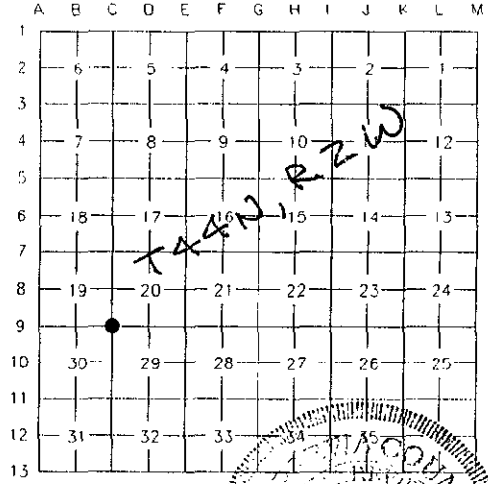

Signed by Keith R. Waters

Date 12-30-98

Surveyor's Michigan License No. 33142