

**SURVEY & REMONUMENTATION**

APR 26 1995

CHIPPEWA COUNTY REMONUMENTATION CORNER

**COMMISSION**

**LAND CORNER RECORDATION CERTIFICATE**  
Filing Requirement of Act 74, Mich. P.A. 1970

For corners in  
Chippewa

(County)

Located In:


Corner Code =#

- |                                    |                          |       |
|------------------------------------|--------------------------|-------|
| 1. Public Land Survey              | T <u>44N</u> R <u>2W</u> | E-1   |
|                                    | T _____ R _____          | _____ |
|                                    | T _____ R _____          | _____ |
|                                    | T _____ R _____          | _____ |
| 2. Property Controlling in Section | S _____ T _____ R _____  | _____ |
|                                    | S _____ T _____ R _____  | _____ |
| 3. Miscellaneous Property in Sec.  | S _____ T _____ R _____  | _____ |
|                                    | S _____ T _____ R _____  | _____ |

\$ 7.00 LAND CORNER  
\$ 2.00 MSSR  
24 OCT 94 3:46 P.M. RECEIPT# 031  
RECEIVED FOR RECORD  
CHIPPEWA COUNTY - STATE OF MICHIGAN  
SHARON H. KENNEDY, REGISTER OF DEEDS

Register of Deeds Stamp & File Number

4. Lot No. \_\_\_\_\_, Recorded Plat \_\_\_\_\_  
5. Private Claims \_\_\_\_\_

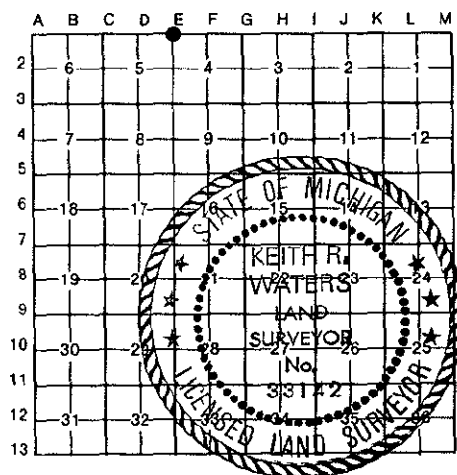

I, Keith R. Waters, in a field survey on June 8, 1994, do hereby certify that under requirements of P.A. 74, Michigan P.A. of 1970, the corner points mentioned in lines 1 and 2 above were in conformance with regulations and rules therefore as required in the current manual of survey instructions of the United States Department of the Interior, Bureau of Land Management or by a decree of a Court of Law and/or that the corner points mentioned in lines 3, 4 and 5 above were in conformance with the rules of the Michigan Board of Land Surveyors or by a Decree of a Court of Law; established, re-established, monumented, re-monumented, recovered, found as expressed below:

**NOTE: Not more than 4 corners, all in the same town and range, may be recorded on this certificate.**

A. Description of original monument and accessories and/or subsequent restoration:

E-1 Corner Common to Sections 4 & 5, on North Boundary of T44N, R2W.  
(Closing Corner on Township Line).

Original ties to post: White Pine 36, S54°W 33 links  
Spruce 10, S57°E 25 links  
1959 - Corner recorded in liber 3, page 225, Chippewa County corner records (Highway Department). Found 1" iron pin.  
Witnesses: T. Pole, S40°E 43.77' T. Pole, S55°W 47.00'

B. Description of corner evidence found and/or method applied in restoring or reestablishing corner:

E-1 (T44N, R2W)  
This corner is being perpetuated as part of the Chippewa County Remonumentation Program.  
Found a 1 1/4" iron pin approximately 1 foot below surface of north-south gravel road (Centerline Road). Found no evidence of witness objects shown in 1959 records. Position works well with established north 1/4 corner and northeast corner of Section 4, T44N, R2W. I believe this corner is the same one as recorded in liber 3, page 225. Accepted corner as found and established four new witness objects.

C. Description of monument for corner and accessories established to perpetuate locating the position of the corner:

E-1 (T44N, R2W)  
Corner is 1 1/4" iron pin 1 foot below surface of Centerline Road (gravel) on the south side of railroad tracks. Witnesses:

- Power Pole, S37°W 94.08'
- Power Pole (97), N44°W 94638'
- Telephone Pole, S49°E 57.24'
- PK Nail w/tag in RR tie, N04°E 15.66'

Note: Distances to poles are to a nail and tag in the side. Bearings are compass bearings corrected for declination.

Signed by Keith R. Waters  
Surveyor's Michigan License No. 33142

Date 10-18-94

