

1999

LAND CORNER RECORDATION CERTIFICATE
Filing Requirement of Act 74, Mich. P.A. 1970
Chippewa County Remonumentation Corner

SECTION

For corners in

Chippewa County	Located in:	Corner Code #
1. Public Land Survey	T44N R2W	E-3
	T R	
	T R	
	T R	
2. Property Controlling in Section	S T R	
	S T R	
3. Miscellaneous Property in Sec.	S T R	
	S T R	
4. Lot No. , Recorded Plat		
5. Private Claims		

\$7.00 LAND CORNER
 \$2.00 NBSR
 5 MAR 1999 1:55:38 PM Receipt #14029
 RECEIVED FOR RECORD
 CHIPPEWA COUNTY - STATE OF MICHIGAN
 SHARON H. KENNEDY, REGISTER OF DEEDS

BOOK **11** PAGE **7**

Register of Deeds Stamp & File Number


I, Keith R. Waters, in a field survey on April 2, 1998, do hereby state that under requirements of P.A. 74, Michigan P.A. of 1970, the corner points mentioned in lines 1 and 2 above were in conformance with regulations and rules therefore as required in the current manual of survey instructions of the United States Department of the Interior, Bureau of Land Management or by a decree of a Court of Law and for that the corner points mentioned in lines 3, 4 and 5 above were in conformance with the rules of the Michigan Board of Land Surveyors or by a Decree of a Court of Law; established, re-established, monumented, recovered, found as expressed below:

NOTE: Not more than 2 corners, all in the same town and range, may be recorded on this certificate.

A. Description of original monument and accessories and/or subsequent restoration:

E-3 Corner Common to Sections 4, 5, 8, & 9, T44N, R2W

- 1845 - Original corner established by James Mullett.
 Witnesses: Black Ash 10, N40°E 14 links - Spruce 8, S05°W 14 links.
- 1907 - Chippewa County Surveyor Frederick H. Brown, RLS 944, notes call this a "Carleton Corner," and put in large cedar post and iron bolt and nut head.
- Circa 1930's - Chippewa County Surveyor corner tie book shows this corner with various witnesses.
- 1959 - Liber 2, page 252, Chippewa County corner records. Michigan State Highway Department, found wooden post, replaced with boat spike. Witnesses: Guy Pole, N60°E 43.87' - F. Post, N38°W 39.89' - T. Pole, S45°W 46.64'.
- 1959 - Liber 3, page 225, Chippewa County corner records. Michigan State Highway Department surveyor Ray Walker, found wooden post, replaced with boat spike. Witnesses: Wood Post, N33°W 39.86' - Guy Pole, N50°E 43.92' Telephone Pole, S44°W 46.76'.
- 1959 - Liber 3, page 227, Chippewa County corner records. Michigan State Highway Department surveyor Ray Walker, corner is a 1" iron pin. Witnesses: P. Pole, N38°E 40.84' - T. Pole, S42°W 46.68' - F. Post, N35°W 43.51'.
- 1990 - LCRC, liber 9, page 143, Chippewa County corner records. Larry R. Rogers, P.S. 29251, found a 1" iron pin in a monument box. Corner works well with others in area. Accepted corner as found. Witnesses:
 Power Pole (RU2/78), N26°W 86.10'
 Anchor Pole (PD4/196A/79), N32°E 85.05'
 "V" cut in south end of 48" Metal Culvert, S68°W 105.76'

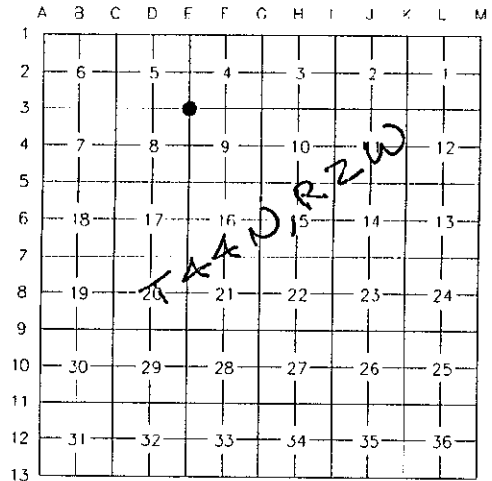

B. Description of corner evidence found and/or method applied in restoring or reestablishing corner:

This corner is being perpetuated as part of the Chippewa County Remonumentation Program.
 Found a 1" pin in a monument box and all three witness objects as called for in the above mentioned 1990 LCRC.



C. Description of monument for corner and accessories established to perpetuate locating the position of the corner:

Found a 1" iron pin in a monument box at the corner location, which falls at the intersection of Highway M-48 east-west and Centerline Road north-south. Witnesses:

- Nail in side of Power Pole (RU2/78), N26°W 86.10'
- Nail in side of Anchor Pole (PD4/196A/79), N32°E 85.05'
- "V" cut in top south end of 48" Metal Culvert, S68°W 105.76'
- Nail and plastic witness tag in side of 4" x 6" Stop Sign Post, S32°E 60.92'



Signed by Keith R. Waters

Date 12-30-98

Surveyor's Michigan License No. 33142