

MAR 18 1999

SECTION


LAND CORNER RECORDATION CERTIFICATE
 Filing Requirement of Act 74, Mich. P.A. 1970
 Chippewa County Remonumentation Corner

\$7.00 LAND CORNER
 \$2.00 MSSR
 5 MAR 1999 2:00:25 PM Receipt #14029
 RECEIVED FOR RECORD
 CHIPPEWA COUNTY - STATE OF MICHIGAN
 SHARON H. KENNEDY, REGISTER OF DEEDS

For corners in

Chippewa County	Located in:	Corner Code #
1. Public Land Survey	T44N R2W	E-9
	T R	
	T R	
	T R	
2. Property Controlling in Section	S T R	
	S T R	
3. Miscellaneous Property in Sec.	S T R	
	S T R	
4. Lot No. , Recorded Plat		
5. Private Claims		

BOOK 11 PAGE 13
 Register of Deeds Stamp & File Number

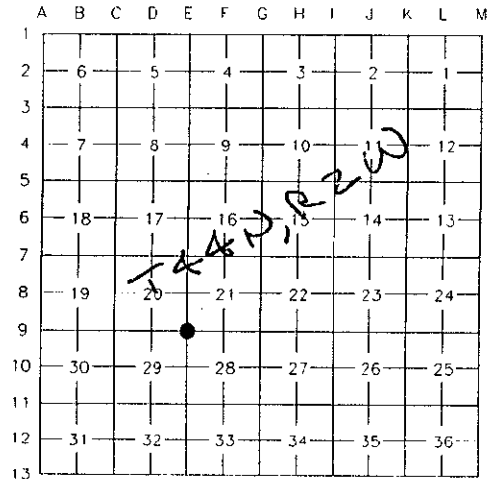

I, Keith R. Waters, in a field survey on November 20, 1998, do hereby state that under requirements of P.A. 74, Michigan P.A. of 1970, the corner points mentioned in lines 1 and 2 above were in conformance with regulations and rules therefore as required in the current manual of survey instructions of the United States Department of the Interior, Bureau of Land Management or by a decree of a Court of Law and /or that the corner points mentioned in lines 3, 4 and 5 above were in conformance with the rules of the Michigan Board of Land Surveyors or by a Decree of a Court of Law; established, re-established, monumented, recovered, found as expressed below:

NOTE: Not more than 2 corners, all in the same town and range, may be recorded on this certificate.

A. Description of original monument and accessories and/or subsequent restoration:

E-9 Corner Common to Sections 20, 21, 28, & 29, T44N, R2W

- 1845 - Original corner established by James Mullett.
 Witnesses: Spruce 12, S50°E 05 links - Fir 8, N68°W 10 links.
- 1897 - Chippewa County Surveyor Frederick H. Brown, RLS 944, indicates that this corner was established by Carleton for highway.
- Circa 1930's - Chippewa County Surveyor corner tie book shows this corner with various witnesses.
- 1959 - Liber 2, page 257, Chippewa County corner records. Michigan State Highway Department surveyor Ray Walker, standard MSHD iron monument box located in macadam on M-48. No witnesses are shown.

B. Description of corner evidence found and/or method applied in restoring or reestablishing corner:

This corner is being perpetuated as part of the Chippewa County Remonumentation Program. Found a 1/2" iron in a monument box at the intersection of Highway M-48 and Centerline Road. Distances to adjacent corners check well with County Surveyor records from the late 1800's and early 1900's. Accepted corner as found.

C. Description of monument for corner and accessories established to perpetuate locating the position of the corner:

Found a 1/2" iron in a monument box at the corner location, which falls in the intersection of Highway M-48 and Centerline Road. Witnesses:

- Nail and plastic witness tag #33142 in side of Power Pole (RU2/24/1), S68°E 163.22'
- Nail and plastic witness tag #33142 in side of Power Pole (RU2/24), S39°W 75.56'
- Northwest corner of Concrete Headwall, N54°E 52.14'
- 12" Diameter Concrete Monument with Brass Tablet (stamped "OVERPASS 1965"), S30°W 65.81'



Signed by Keith R. Waters

Date 12-30-98

Surveyor's Michigan License No. 33142