

MAR 8 1999

SECTION

LAND CORNER RECORDATION CERTIFICATE

Filing Requirement of Act 74, Mich. P.A. 1970

Chippewa County Remonumentation Corner

For corners in

Chippewa County	Located in:	Corner Code #
1. Public Land Survey	T44N R2W	G-7
	T R	
	T R	
	T R	
2. Property Controlling in Section	S T R	
	S T R	
3. Miscellaneous Property in Sec.	S T R	
	S T R	
4. Lot No.	, Recorded Plat	
5. Private Claims		

\$7.00 LAND CORNER
 \$7.00 LAND CORNER
 5 MAR 1999 2:09:26 PM Receipt #14029
 RECEIVED FOR RECORD
 CHIPPewa COUNTY - STATE OF MICHIGAN
 SHARON H. KENNEDY, REGISTER OF DEEDS

BOOK 11 PAGE 26
 Register of Deeds Stamp & File Number


I, Keith R. Waters, in a field survey on April 13, 1998, do hereby state that under requirements of P.A. 74, Michigan P.A. of 1970, the corner points mentioned in lines 1 and 2 above were in conformance with regulations and rules therefore as required in the current manual of survey instructions of the United States Department of the Interior, Bureau of Land Management or by a decree of a Court of Law and /or that the corner points mentioned in lines 3, 4 and 5 above were in conformance with the rules of the Michigan Board of Land Surveyors or by a Decree of a Court of Law; established, re-established, monumented, recovered, found as expressed below:

NOTE: Not more than 2 corners, all in the same town and range, may be recorded on this certificate.

A. Description of original monument and accessories and/or subsequent restoration:

G-7 Corner Common to Sections 15, 16, 21, & 22, T44N, R2W

- 1845 - Original corner established by James Mullett.
Witnesses: Spruce 10, N30°E 49 links - Spruce 8, S30°W 17 links.
- 1897 - Chippewa County Surveyor Frederick H. Brown, RLS 944, notes for Section 15 indicate corner by Chamberlain of Mackinac County.
- 1915 - Brown's notes for Section again indicate a "Chamberlain corner, took corner as used and reference: Spruce 8, N69°W 69.
- Circa 1930's - Chippewa County Surveyor corner tie book indicates a large cedar post and 24" concrete monument at the corner location, along with several witnesses.
- 1991 - LCRC, liber 7, page 338, Chippewa County corner records. Keith R. Waters, P.S. 33142, found a concrete monument 1 foot below gravel road surface. Distance east to southeast corner of Section 15 matches old County Surveyor notes. Witnesses:
Power Pole (PD4/164/15), N43°W 48.08'
Power Pole (PD4/20/37M), S07°W 272.20'
Stop Sign, N75°E 41.24'
Street Sign, S56°E 48.73'

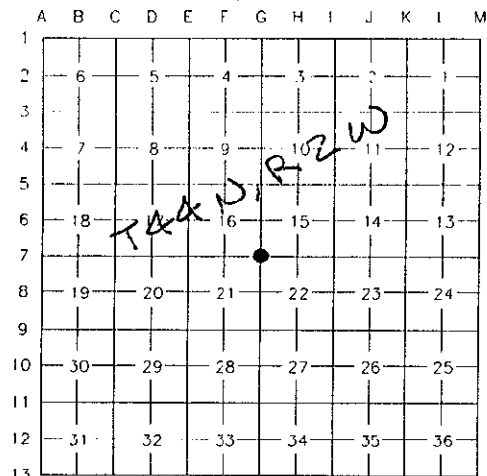

B. Description of corner evidence found and/or method applied in restoring or reestablishing corner:

This corner is being perpetuated as part of the Chippewa County Remonumentation Program. Found a concrete monument and all witness objects as called for in the above mentioned 1991 LCRC.



C. Description of monument for corner and accessories established to perpetuate locating the position of the corner:

Found a concrete monument at the corner location, which falls 4 feet west of the centerline of Hantz Road north-south, at the centerline of 21 Mile Road to the east. Witnesses:

- Nail and plastic witness tag #22428 over existing PK nail in side of Power Pole (PD4/164/15), N43°W 48.08'
- PK nail in side of Power Pole (PD4/20/37M), S07°W 272.20'
- Center of base of metal Stop Sign Post, N75°E 41.24'
- Nail and plastic witness tag #22428 over existing PK nail in side of Street Sign Post, S56°E 48.73'



Signed by Keith R. Waters

Date 12-30-98

Surveyor's Michigan License No. 33142