

MAR 09 1994

CHIPPEWA COUNTY REMONUMENTATION CORNER

RECEIVED FOR RECORD
CHIPPEWA COUNTY
STATE OF MICHIGAN

93 DEC 30 PM 2:44

COMMISSION

LAND CORNER RECORDATION CERTIFICATE

Filing Requirement of Act 74, Mich. P.A. 1970

J. Roger Malott
REGISTER OF DEEDS

Register of Deeds Stamp & File Number

For corners in
Chippewa


(County)	Located In:	Corner Code #
1. Public Land Survey	T <u>45N</u> R <u>1E</u>	C-7
	T _____ R _____	_____
	T _____ R _____	_____
	T _____ R _____	_____
2. Property Controlling in Section	S _____ T _____ R _____	_____
	S _____ T _____ R _____	_____
3. Miscellaneous Property in Sec.	S _____ T _____ R _____	_____
	S _____ T _____ R _____	_____

4. Lot No. _____, Recorded Plat _____
5. Private Claims _____

I, Keith R. Waters in a field survey on November 23, 1993

do hereby certify that under requirements of P.A. 74, Michigan P.A. of 1970, the corner points mentioned in lines 1 and 2 above were in conformance with regulations and rules therefore as required in the current manual of survey instructions of the United States Department of the Interior, Bureau of Land Management or by a decree of a Court of Law and/or that the corner points mentioned in lines 3, 4 and 5 above were in conformance with the rules of the Michigan Board of Land Surveyors or by a Decree of a Court of Law; established, re-established, monumented, re-monumented, recovered, found as expressed below:

NOTE: Not more than 4 corners, all in the same town and range, may be recorded on this certificate.

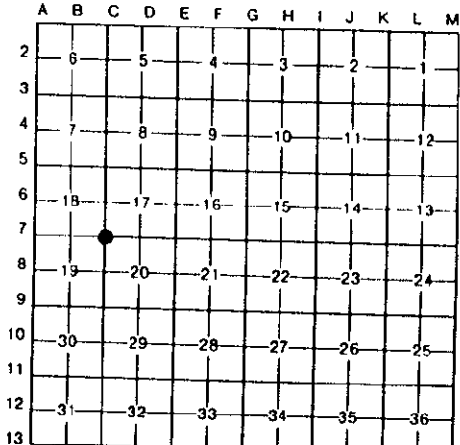

A. Description of original monument and accessories and/or subsequent restoration:

C-7 Corner Common to Sections 17, 18, 19, & 20, T45N, R1E
Original ties to post: Fir 12, N12°W 26 links Fir 6, S61°W 46 links

Michigan State Highway Department (11-29-65) as recorded in liber 2 of Chippewa County corner records: Found a 1" iron pin with the following ties: P. Pole, N30°E 56.22'
1"x2" Stake, S30°W 51.62'
1"x2" Stake, S20°E 50.32'



B. Description of corner evidence found and/or method applied in restoring or reestablishing corner:

C-7 (T45N, R1E)
This corner is being perpetuated as part of the Chippewa County Remonumentation Program.
Found a 1/2" iron pin with plastic cap #27450 (William L. Karr) in a monument box in the centerline of east-west asphalt road (15 Mile Road) at the intersection of a gravel road to the north (Seymour Road). Distances to Section corners west and north are within 0.92 feet and 1.06 feet respectively, of those as shown on 1965 Highway Department records. Accepted corner as found and established witness objects.

Description of monument for corner and accessories established to perpetuate locating the position of the corner:

C-7 (T45N, R1E)
Corner is a 1/2" iron pin with cap #27450 in a monument box in centerline of 15 Mile Road at Seymour Road to the north. Witnesses:

- Fence Corner, S17°E 54.69'
- Power Pole, N36°E 57.17'
- 1/2" Iron w/cap #33142, S02°W 32.97'
- PK Nail in Asphalt Approach, N02°E 33.00'

Note: Distances to fence corner and power pole are to a PK nail in the side. Bearings are compass bearings corrected for declination.

Surveyed by Keith R. Waters
Surveyor's Michigan License No. 33142

Date 12-30-93