

SURVEY &
REMONUMENTATION

MAR 09 1994

CHIPPEWA COUNTY REMONUMENTATION CORNER

COMMISSION

LAND CORNER RECORDATION CERTIFICATE
Filing Requirement of Act 74, Mich. P.A. 1970

For corners in
Chippewa

(County)

Located In:

Corner Code #

- | | | |
|------------------------------------|-------------------------|-------|
| 1. Public Land Survey | T 45N R 1E | E-7 |
| | T _____ R _____ | _____ |
| | T _____ R _____ | _____ |
| | T _____ R _____ | _____ |
| 2. Property Controlling in Section | S _____ T _____ R _____ | _____ |
| | S _____ T _____ R _____ | _____ |
| 3. Miscellaneous Property in Sec. | S _____ T _____ R _____ | _____ |
| | S _____ T _____ R _____ | _____ |

RECEIVED FOR RECORD
CHIPPEWA COUNTY,
MICHIGAN


93 DEC 30 PM 2:45

J. Roger Melick

REGISTER OF DEEDS

Register of Deeds Stamp & File Number

4. Lot No. _____, Recorded Plat _____
5. Private Claims _____

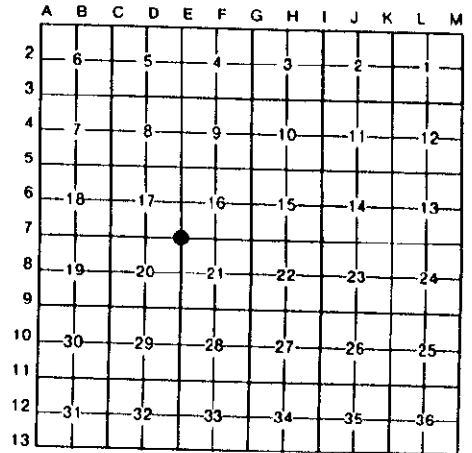

I, Keith R. Waters in a field survey on November 23, 1993 do hereby certify that under requirements of P.A. 74, Michigan P.A. of 1970, the corner points mentioned in lines 1 and 2 above were in conformance with regulations and rules therefore as required in the current manual of survey instructions of the United States Department of the Interior, Bureau of Land Management or by a decree of a Court of Law and/or that the corner points mentioned in lines 3, 4 and 5 above were in conformance with the rules of the Michigan Board of Land Surveyors or by a Decree of a Court of Law; established, re-established, monumented, re-monumented, recovered, found as expressed below:

NOTE: Not more than 4 corners, all in the same town and range, may be recorded on this certificate.

A. Description of original monument and accessories and/or subsequent restoration:

E-7 Corner Common to Sections 16, 17, 20, & 21, T45N, R1E
Original ties to post: Fir 8, S43°E 11 links Cedar 10, N43°W 20 links
1903 - This corner is shown in County Surveyor notes as an original U.S. corner, with various witnesses.

B. Description of corner evidence found and/or method applied in restoring or reestablishing corner:

E-7 (T45N, R1E)
This corner is being perpetuated as part of the Chippewa County Remonumentation Program.
Found a 3/4" iron with plastic cap #33986 (Stephan J. Szyszkoski) in the approximate centerline of east-west asphalt road (15 Mile Road) at the intersection of gravel road to the north (Shunk Road). In talking with Steve, he indicated that he established corner location using ties as shown in above mentioned County Surveyor notes, including an old school building to the northeast and a small boulder to the southeast. Accepted corner as found and established witness objects.



C. Description of monument for corner and accessories established to perpetuate locating the position of the corner:

E-7 (T45N, R1E)
Corner is a 3/4" iron pipe with plastic cap "MICH DNR LS 33986" in the centerline of 15 Mile Road at the intersection of Shunk Road to the north.
Witnesses:

- Fence Corner, N70°E 131.25'
- Fence Corner, S30°W 58.70'
- Power Pole, N19°W 56.35'
- Power Pole, S26°E 52.45'

Note: Distances are to a nail and tag in the side of the witness object. Bearings are compass bearings corrected for declination.

Signed by Keith R. Waters Date 12-30-93
Surveyor's Michigan License No. 33142