

CHIPPEWA COUNTY REMONUMENTATION CORNER

MAR 09 1994

LAND CORNER RECORDATION CERTIFICATE

Filing Requirement of Act 74, Mich. P.A. 1970

For corners in CHIPPEWA (County)

	Located In:	Corner Code #
1. Public Land Survey	T <u>45N</u> R <u>1E</u>	<u>F-7</u>
	T _____ R _____	_____
	T _____ R _____	_____
	T _____ R _____	_____
2. Property Controlling in Section	S _____ T _____ R _____	_____
	S _____ T _____ R _____	_____
3. Miscellaneous Property in Sec.	S _____ T _____ R _____	_____
	S _____ T _____ R _____	_____

RECEIVED FOR RECORD  
CHIPPEWA COUNTY  
STATE OF MICHIGAN


93 DEC 30 PM 2:45

*J. Roger Malott*

REGISTER OF DEEDS

Register of Deeds Stamp & File Number

- 4. Lot No. \_\_\_\_\_, Recorded Plat \_\_\_\_\_
- 5. Private Claims \_\_\_\_\_

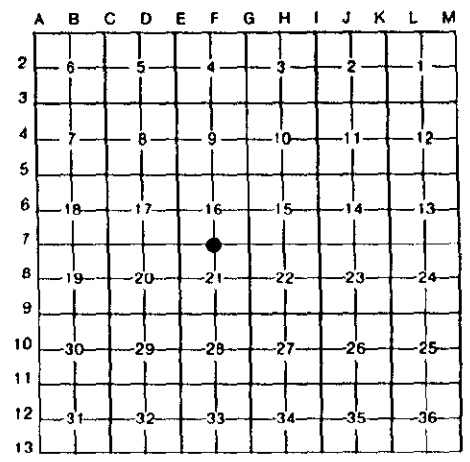

I, Keith R. Waters in a field survey on November 23, 1993, do hereby certify that under requirements of P.A. 74, Michigan P.A. of 1970, the corner points mentioned in lines 1 and 2 above were in conformance with regulations and rules therefore as required in the current manual of survey instructions of the United States Department of the Interior, Bureau of Land Management or by a decree of a Court of Law and/or that the corner points mentioned in lines 3, 4 and 5 above were in conformance with the rules of the Michigan Board of Land Surveyors or by a Decree of a Court of Law; established, re-established, monumented, re-monumented, recovered, found as expressed below:

**NOTE: Not more than 4 corners, all in the same town and range, may be recorded on this certificate.**

A. Description of original monument and accessories and/or subsequent restoration:

F-7 1/4 Corner Common to Sections 16 & 21, T45N, R1E

Original ties to post: Aspen 6, N65°E 16 links  
Birch 10, S49°W 09 links



B. Description of corner evidence found and/or method applied in restoring or reestablishing corner:

F-7 (T45N, R1E)

This corner is being perpetuated as part of the Chippewa County Remonumentation Program.

Found a 1/2" iron pin with plastic cap #29251 (Larry R. Rogers) in centerline of east-west asphalt road (15 Mile Road). Corner is approximately 2.5 feet west of a fence line to the north and approximately 2.5 feet east of a fence line to the south. Distance to Section corner east is 2639.96 feet and distance to Section corner west is 2633.82 feet. Corner is 1.48 feet north of a straight line between said Section corners. Accepted corner as found.

C. Description of monument for corner and accessories established to perpetuate locating the position of the corner:

F-7 (T45N, R1E)

Corner is a 1/2" iron pin with cap #29251 in centerline of 15 Mile Road.

Witnesses:

- Fence Post, S45°E 77.05'
- Power Pole (656), N75°W 210.56'
- Power Pole, N82°E 213.46'
- Corner Fence Post, N07°E 51.56'

Note: Distance to fence post is to a nail and witness tag in the side. Distances to corner fence post and power poles are to a nail with cap #29251 in side. Bearings are compass bearings corrected for declination.

Signed by Keith R. Waters

Date 12-30-93

Surveyor's Michigan License No. 33142