

**SURVEY & REMONUMENTATION**

FILED TO FILE 11/19/97

APR 07 1998

**LAND CORNER RECORDATION CERTIFICATE**  
**Filing Requirement of Act 74, Mich. P.A. 1970**  
 Chippewa County Remonumentation Corner

For corners in **SECTION**

Chippewa County	Located in:	Corner Code #
1. Public Land Survey	T45N R2W	C-11
	T R	
	T R	
	T R	
2. Property Controlling in Section	S T R	
	S T R	
3. Miscellaneous Property in Sec.	S T R	
	S T R	
4. Lot No. , Recorded Plat		
5. Private Claims		

\$7.00 LAND CORNER  
 \$2.00 MSSR  
 6 Mar 1998 1:37:05 PM Receipt #6451  
 RECEIVED FOR RECORD  
 CHIPPEWA COUNTY - STATE OF MICHIGAN  
 SHARON H. KENNEDY, REGISTER OF DEEDS

BOOK 10 PAGE 173

Register of Deeds Stamp & File Number

I, Keith R. Waters, in a field survey on April 11, 1997, do hereby state that under requirements of P.A. 74, Michigan P.A. of 1970, the corner points mentioned in lines 1 and 2 above were in conformance with regulations and rules therefore as required in the current manual of survey instructions of the United States Department of the Interior, Bureau of Land Management or by a decree of a Court of Law and/or that the corner points mentioned in lines 3, 4 and 5 above were in conformance with the rules of the Michigan Board of Land Surveyors or by a Decree of a Court of Law, established, re-established, monumented, recovered, found as expressed below:

NOTE: Not more than 2 corners, all in the same town and range, may be recorded on this certificate.

A. Description of original monument and accessories and/or subsequent restoration:

C-11 Corner common to Sections 29, 30, 31, & 32, T45N, R2W

- 1849 - Original corner (spruce post) was established by Harvey Mellen, D.S. Witnesses: Spruce 12, N66°E 67 links - Yellow Birch, S37°W 62 links
- 1921 - County Surveyor Frederick H. Brown notes for Section 30 indicate that Kraft (identity unknown) made a corner here on the west side of the road, but the original corner was where the road is now. He states that he saw the corner when it was woods in a survey for timber.
- 1924 - County Surveyor Brown again indicates Kraft made a corner west of the road. Brown states that he (Brown) put the monument very near the center of the roads each way, as the State engineers used it that way when the road was made.
- Circa 1930 - Chippewa County Surveyor corner tie book shows a 1 1/4" x 36" gas pipe at the corner location. Numerous witnesses are shown including fence corners, poles, and sign boards. Distances are shown to what I assume are sections corners east and west of 5250 feet and 5200 feet, respectively. It appears from the sketch that the corner is in the approximate center of the intersection of east-west and north-south roads.

B. Description of corner evidence found and/or method applied in restoring or reestablishing corner:



This corner is being perpetuated as part of the Chippewa County Remonumentation Program. Found a 1/2" rebar in the approximate center of the intersection of Tilson Road and 17 Mile Road. Found no evidence of any of the witnesses as shown in County Surveyor corner tie book. The distance to section corner E-11 to the east is 5254.6 feet, County Surveyor corner tie book shows 5250. The distance to section corner A-11 to the west is 5310.4 feet, County Surveyor corner tie book shows 5200, possibly it should have been 5300. The distance west is within 0.6 feet of the original GLO distance (5311). Accepted corner position as found.

C. Description of monument for corner and accessories established to perpetuate locating the position of the corner:

Found a 1/2" rebar at the corner location, which is at the approximate center of the intersection of Tilson Road north-south and 17 Mile Road east-west.  
 Witnesses:

- Power Pole, S48°E 52.72'
- Guy Pole (E54-01), N54°E 46.80'
- Guy Pole, N54°W 42.14'
- Power Pole (RU2-115-18), S77°W 146.60'

Note: Distances are to a nail/tag #33142 in the side of the pole.  
 Bearings are compass bearings corrected for declination.

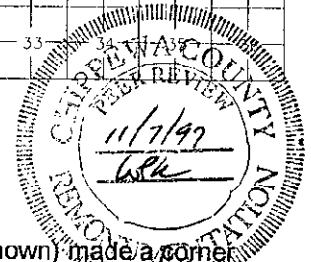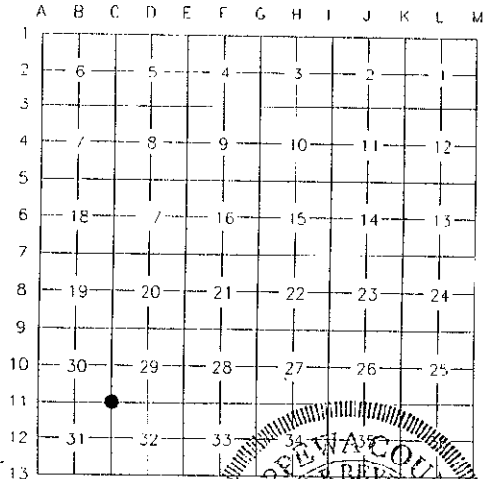

Signed by Keith R. Waters

Date 12-30-97

Surveyor's Michigan License No. 33142