

SURVEY
REMONUMENTATION: CHIPPEWA COUNTY REMONUMENTATION CORNER

MAR 09 1994

LAND CORNER RECORDATION CERTIFICATE
 Filing Requirement of Act 74, Mich. P.A. 1970

For corners in
 Chippewa **COMMISSION**
 (County)


RECEIVED FOR RECORD
 CHIPPEWA COUNTY
 STATE OF MICHIGAN

93 DEC 30 PM 2:46

J. Roger Matlock
 REGISTER OF DEEDS

Register of Deeds Stamp & File Number

	Located In:	Corner Code #/
1. Public Land Survey	T <u>45N</u> R <u>2E</u>	B-7
	T _____ R _____	_____
	T _____ R _____	_____
	T _____ R _____	_____
2. Property Controlling in Section	S _____ T _____ R _____	_____
	S _____ T _____ R _____	_____
3. Miscellaneous Property in Sec.	S _____ T _____ R _____	_____
	S _____ T _____ R _____	_____
4. Lot No. _____, Recorded Plat _____		
5. Private Claims _____		

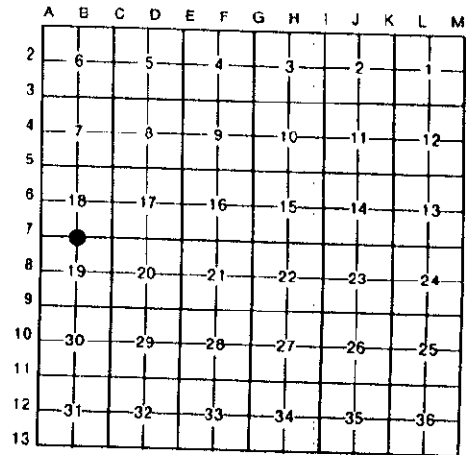

Keith R. Waters in a field survey on November 29 1993
 Do hereby certify that under requirements of P.A. 74, Michigan P.A. of 1970, the corner points mentioned in lines 1 and 2 above were in conformance with regulations and rules therefore as required in the current manual of survey instructions of the United States Department of the Interior, Bureau of Land Management or by a decree of a Court of Law and/or that the corner points mentioned in lines 3, 4 and 5 above were in conformance with the rules of the Michigan Board of Land Surveyors or by a Decree of a Court of Law; established, re-established, monumented, re-monumented, recovered, found as expressed below:

NOTE: Not more than 4 corners, all in the same town and range, may be recorded on this certificate.

Description of original monument and accessories and/or subsequent restoration:

B-7 1/4 Corner Common to Sections 18 & 19, T45N, R2E

Original ties to post: Hemlock 12, N36°E 11 links Hemlock 10, S61°W 28 links

This corner is recorded in liber 1, page 207, Chippewa County corner records by Neree D. Alix, R.L.S. 6254 (1976), as a found 1" pipe in centerline of road
 Record ties: 6" Red Pine, N40°W 57.0' SE Corner Garage, N49°W 63.3'
 Utility Pole, S68°W 129.3' 1/2" Rerod, S22°E 52.5'

Corner also shown on Assessor's Plat No. 1 of Bruce Township as a 3/4" pipe.

Description of corner evidence found and/or method applied in restoring or reestablishing corner:

B-7 (T45N, R2E)

This corner is being perpetuated as part of the Chippewa County Remonumentation Program.

Found a 1/2" iron pin with plastic cap #27450 (William L. Karr) in a monument box 0.8 feet north of centerline of east-west asphalt road (15 Mile Road). Distance to lone remaining witness from previous recording (1/2" rerod) checks within 0.12 feet. Accepted corner as found and established new witness objects.

*WJKM
 12/12/93*

Description of monument for corner and accessories established to perpetuate locating the position of the corner:

B-7 (T45N, R2E)

Corner is a 1/2" iron pin with cap #27450 in a monument box 0.8 feet north of the centerline of 15 Mile Road. Witnesses:

- Nail w/tag #27450 in Power Pole (DR2-230), S65°W 129.44'
- 1/2" Rerod, S15°E 52.38'
- Nail w/tag #33142 in 8" Aspen, N27°E 51.66'
- SE Corner of New Garage, N34°W 97.91'

Note: Bearings are compass bearings corrected for declination. Aspen is blazed and painted.



Recorded by Keith R. Waters
 Surveyor's Michigan License No. 33142

Date 12-30-93