

**SURVEY &  
REMONUMENTATION**

**CHIPPEWA COUNTY REMONUMENTATION CORNER**

APR 27 1995

**LAND CORNER RECORDATION CERTIFICATE**  
Filing Requirement of Act 74, Mich. P.A. 1970

For corners in COMMISSION  
Chippewa  
(County)

Located In: Corner Code ##

- |                                       |                          |            |
|---------------------------------------|--------------------------|------------|
| 1. Public Land Survey                 | T <u>46N</u> R <u>1W</u> | <u>I-8</u> |
|                                       | T _____ R _____          | _____      |
|                                       | T _____ R _____          | _____      |
|                                       | T _____ R _____          | _____      |
| 2. Property Controlling in Section    | S _____ T _____ R _____  | _____      |
|                                       | S _____ T _____ R _____  | _____      |
| 3. Miscellaneous Property in Sec.     | S _____ T _____ R _____  | _____      |
|                                       | S _____ T _____ R _____  | _____      |
| 4. Lot No. _____, Recorded Plat _____ |                          |            |
| 5. Private Claims _____               |                          |            |

\$ 7.00 LAND CORNER  
\$ 2.00 MSSR  
24 OCT 94 3:50 P.M. RECEIPT# 831  
RECEIVED FOR RECORD  
CHIPPEWA COUNTY - STATE OF MICHIGAN  
SHARON H. KENNEDY, REGISTER OF DEEDS

Register of Deeds Stamp & File Number

I, Keith R. Waters in a field survey on May 3, 19 94, do hereby certify that under requirements of P.A. 74, Michigan P.A. of 1970, the corner points mentioned in lines 1 and 2 above were in conformance with regulations and rules therefore as required in the current manual of survey instructions of the United States Department of the Interior, Bureau of Land Management or by a decree of a Court of Law and/or that the corner points mentioned in lines 3, 4 and 5 above were in conformance with the rules of the Michigan Board of Land Surveyors or by a Decree of a Court of Law; established, re-established, monumented, re-monumented, recovered, found as expressed below:

**NOTE: Not more than 4 corners, all in the same town and range, may be recorded on this certificate.**

A. Description of original monument and accessories and/or subsequent restoration:

I-8 1/4 Corner Common to Sections 22 & 23, T46N, R1W

Original ties to post: Fir 10, N35°E 23 links  
Spruce 10, S65°W 34 links

Old County Surveyor notes show the distance from this corner to the Southeast corner of Section 22 as 2635 feet.

1961 - Corner is shown on the recorded plat of Holiday Subdivision, by Rudolph H. Larsen, R.L.S. 3644.

B. Description of corner evidence found and/or method applied in restoring or reestablishing corner:

I-8 (T46N, R1W)

This corner is being perpetuated as part of the Chippewa County Remonumentation Program.

Found a 4½" diameter concrete monument with a brass tablet stamped "CHIPPEWA COUNTY CORNER" at the intersection of fence lines to the west and to the south. Corner is 2621.15 feet from section corner to the north, 2630.33 feet from section corner to the south, and is 2.95 feet west of a straight line between said section corners. Monument has been used for numerous surveys in the area. Accepted corner as found and established four witness objects.



C. Description of monument for corner and accessories established to perpetuate locating the position of the corner:

I-8 (T46N, R1W)

Corner is 4½" diameter concrete monument at the intersection of fence lines south and west. Witnesses:

- 3" Spruce, S74°E 75.34'
- 4" Spruce, S08°E 57.06'
- Power Pole, WEST 91.20'
- 6" Spruce, N75°W 126.18'

Note: Distances are to a nail and tag in the side of the witness object. Trees are blazed and painted. Bearings are compass bearings corrected for declination

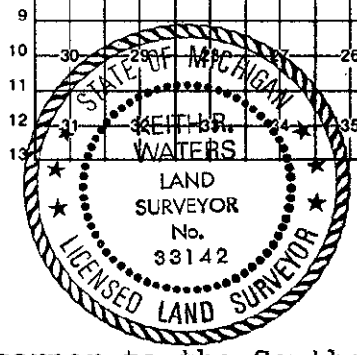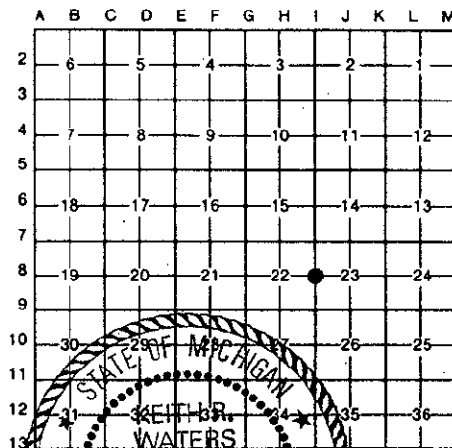

Signed by Keith R. Waters

Date 10-18-94

Surveyor's Michigan License No. 33142

