

**SURVEY & REMONUMENTATION**

**LAND CORNER RECORDATION CERTIFICATE**  
 Filing Requirement of Act 74, Mich. P.A. 1970  
 Chippewa County Remonumentation Corner

**APR 07 1998**

For corners in

**SECTION**

Chippewa

Located In:

Corner Code #

1. Public Land Survey

T 46N R 2W ✓

A-9 Same

T 46N R 3W

M-9 Corner

T R

T R

2. Property Controlling in Section

S T R

S T R

3. Miscellaneous Property in Sec.

S T R

S T R

\$7.00 LAND CORNER

\$2.00 MSSR

12 Mar 1998 12:36:36 PM Receipt #

RECEIVED FOR RECORD

CHIPPewa COUNTY - STATE OF MICHIGAN

SHARON H. KENNEDY, REGISTER OF DEEDS


BOOK 10 PAGE 213

Register of Deeds Stamp & File Number

4. Lot No. \_\_\_\_\_, Recorded Plat \_\_\_\_\_  
 5. Private Claims \_\_\_\_\_

I, William L. Karr, in a field survey on November 13, 1997, do hereby state that under requirements of P.A. 74, Michigan P.A. of 1970, the corner points mentioned in lines 1 and 2 above were in conformance with regulations and rules therefore as required in the current manual of survey instructions of the United States Department of the Interior, Bureau of Land Management or by a decree of a Court of Law and/or that the corner points mentioned in lines 3, 4 and 5 above were in conformance with the rules of the Michigan Board of Land Surveyors or by a Decree of a Court of Law; established, re-established, monumented, recovered, found as expressed below

**NOTE: Not more than 2 corners, all in the same town and range, may be recorded on this certificate.**

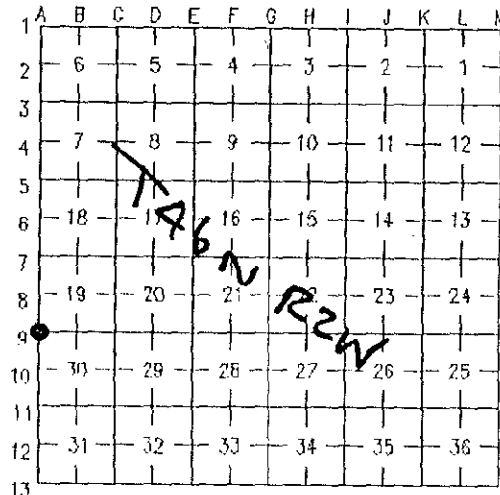

A. Description of original monument and accessories and/or subsequent restoration:

(A-9) Section Corner Common to Sections 19 and 30, T.46 N., R.2 W., and Sections 24 and 25, T.46 N., R.3 W.  
 1840 Austin Burt, D.S. set post in original survey. Witnesses: Sugar 6 S44°W 23  
 Sugar 12 N49°W 8

1903 F.H. Brown, County Surveyor, (Section book) ran West line of Section 19 and found bearing trees at this position and set a Cedar post and monument.

??? County Surveyor corner tie book, (page 111) shows a large Cedar post and monument for corner along with (4) witnesses

B. Description of corner evidence found and/or method applied in restoring or reestablishing corner:

(A-9) Section Corner Common to Sections 19 and 30, T.46 N., R.2 W., and Sections 24 and 25, T.46 N., R.3 W.  
 This corner is being perpetuated as part of the Chippewa County Remonumentation Program.

Found no evidence of the original corner. Found a very old concrete monument and Cedar post (cut off below grade) as noted in Part A. None of the witnesses remained. Pulled the monument and set a 3/4" x 24" iron and buried the monument in the hole next to the new iron. Distance North to 1/4 corner 24/19 is 2640.48'; distance South to 1/4 corner 30/25 is 2631.02'. Accepted the position as found.

C. Description of monument for corner and accessories established to perpetuate locating the position of the corner:

(A-9) Section Corner Common to Sections 19 and 30, T.46 N., R.2 W., and Sections 24 and 25, T.46 N., R.3 W.  
 Corner is a 3/4" x 24" iron with plastic Chippewa County Remonumentation Corner cap on the extension of centerline of roads to the North and West.

Witnesses: Elm 6" N16°E 86.52' (existing tag)  
 Power pole N80°E 50.39' (existing tag)  
 Aspen 10" (dead) S89°W 40.67'  
 Apple 6" N55°W 77.27' (existing tag)

Signed by William L. Karr

Date 12/29/97

Surveyor's Michigan License No. 27450

NOTE: All bearings are compass bearings corrected for declination (6°W). All distances are to a nail and tag in the side of witness object unless otherwise noted.

