

LAND CORNER RECORDATION CERTIFICATE

Filing Requirement of Act 74, Mich. PA 1970

For Corners In: Gladwin Located In _____ Corner Code # _____
(County)

1. Public Land Survey	T	<u>18N</u>	R	<u>1E</u>	<u>G2</u>
	T	_____	R	_____	_____
2. Property Controlling in Section	S	T	R	_____	_____
	S	T	R	_____	_____
3. Miscellaneous Property in Section	S	T	R	_____	_____
	S	T	R	_____	_____


Register of Deeds Stamp & File Number

4. Lot No: _____ Recorded Plat: _____

5. Private Claims: _____

I, Craig W. McVean, in a field survey on Aug. 10, 2010 do hereby state that under requirements of PA 74, Michigan PA of 1970, the corner points mentioned in lines 1 and 2 above were in conformance with regulations and rules therefore as required in the current manual of survey instructions of the United States Department of the Interior, Bureau of Land Management or by a decree of a Court of Law and/or that the corner points mentioned in lines 3, 4 and 5 above were in conformance with the rules of the Michigan Board of Land Surveyors or by a Decree of a Court of Law; established, re-established, monumented, recovered, found as expressed below:

NOTE: Not more than 2 corners, all in the same town and range, may be recorded on this certificate.

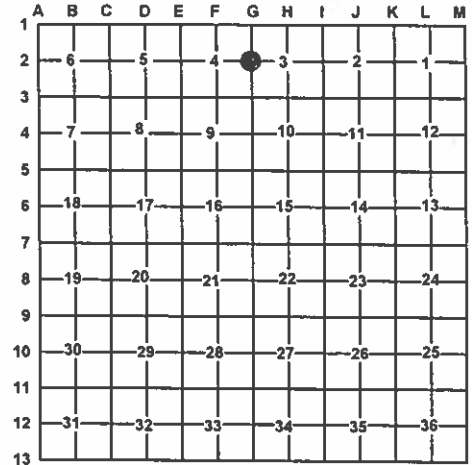

A. Description of original monument and accessories and/or subsequent restoration:

G2 – 1846 – GLO – J. Mullett – Set ¼ Post
 1) B. Ash 12" S9°W 26 L.
 2) Beech 10" N9°E 37 L.
 - 1930's – CCC – 101.98 – South. Set random ¼ Post
 - 1974 – Record Survey – L. 1, p. 407 – L. D. McGinnis – Shows E. Line of Sec. 4 but not ¼ corner.

B. Description of corner evidence found and/or method applied in restoring or re-establishing corner:

G2 – ¼ Corner common to sections 3 & 4, T18N, R1E - Searched area and found no evidence of corner or GLO BT's. Set Stamped 4" Aluminum DNR cap on 1" x 36" galvanized iron pipe by single proportion to GLO between corners 'G3' and 'G1'. The McGinnis survey used corner 'G13', T19N, R1E not 'G1', T18N, R1E for the NE Corner of Sec. 4 in his survey. 'G1' is 5.28' East of 'G13'. Thus by calculation 'G2' would be 3.4' East of the N-S Survey line by McGinnis. Measured grid distance North 1410.95' (1450.68' – GLO) to 'G1' and south 2567.70' (2640' – GLO) to 'G3'. DNR Monument accepted as a careful and faithful re-establishment of the position of the original corner.

C. Description of monument for corner and accessories established to perpetuate locating the position of the corner:

G2 – Stamped 4" Aluminum Cap on a 1" x 36" galvanized iron pipe
 N67°E 57.95' to set Nail & Tag in SE side Power Pole
 N35°E 11.80' to set Nail & Tag in NW side 8" Red Maple
 S30°E 8.74' to set Nail & Tag in E. side 5" Red Maple scribed 'XBT'
 S28°W 13.28' to set Nail & Tag in E. side 11" Oak
 N22°W 17.09' to set Nail & Tag in W. side 5" Red Maple scribed 'XBT'
 Set Blue Carsonite Post 1' East



Signed by: Craig W. McVean
 Surveyor's Michigan License No.: 39088

Date: 1/26/2012