

**LAND CORNER RECORDATION CERTIFICATE**

Filing Requirement of Act 74, Mich. P.A. 1970

LIBER 2 PAGE 326


STATE OF MICHIGAN  
 COUNTY OF KALAMAZOO  
 RECEIVED FOR RECORD  
 '98 OCT 12 PM 1 29  
 J. J. Johnson  
 CLERK - REGISTER

Register of Deeds Stamp & File Number

For corners in CITY OF PORTAGE Located In: Corner Code #  
KALAMAZOO (County)

1. Public Land Survey	T	3S.	R	11W.	E-5
	T		R		
	T		R		
	T		R		
2. Property Controlling in Section	S	T	R		
	S	T	R		
3. Miscellaneous Property in Section	S	T	R		
	S	T	R		

- 4. Lot No. \_\_\_\_\_, Recorded Plat \_\_\_\_\_
- 5. Private Claims \_\_\_\_\_
- 6. IWM Job No. 30661

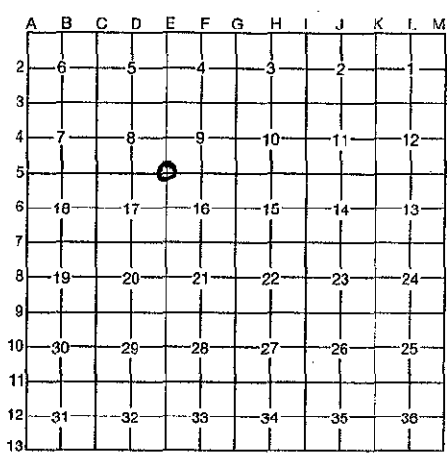

I, Allen H. McMachen, in a field survey on March 23, 1998  
 do hereby certify that under requirements of P.A. 74, Michigan P.A. of 1970, the corner points mentioned in lines 1 and 2 above were in conformance with regulations and rules therefore as required in the current manual of survey instructions of the United States Department of the Interior, Bureau of Land Management or by a decree of a Court of Law and/or that the corner points mentioned in lines 3, 4 and 5 above were in conformance with the rules of the Michigan Board of Professional Surveyors or by a Decree of a Court of Law; established, re-established, monumented, re-monumented, recovered, found as expressed below:

**NOTE: Not more than 4 corners, all in the same town and range, may be recorded on this certificate.**

**A. Description of original monument and accessories and/or subsequent restoration:**

1827 - Robert Clark, Jr., D.S., Set post, Corner to Sec. 8, 9, 16 & 17, Y. Oak 12" S. 45° W. 36 lks., Y. Oak 20" S. 66° E. 20 lks..

1947 - Plat of "Kiltz Acres" is recorded in Liber 16, Page 28 showing Section corner. Monument was placed 33' North of Section corner.

1977 - Sewer was installed near centerline of Romence Road and removed Section corner.

**B. Description of corner evidence found and/or method applied in restoring or reestablishing corner:**

No corner marker was found. Reestablished corner location from monumentation found in the 1947 plat.

SURVEY &  
 MONUMENTATION  
 NOV 25 1998  
 SECTION

RATIFIED  
 BY KALAMAZOO COUNTY  
 REMONUMENTATION  
 PEER GROUP  
 5/21/98  
 R. J. [Signature]

**C. Description of monument for corner and accessories established to perpetuate locating the position of the corner:**

Position above described is accepted as a careful and faithful reestablishment of the position of the original corner. Placed 30" Harrison Monument at said accepted position and monument box over, Accessories:

- Found concrete plat monument North 33.00'
- Nail & Tab in East face utility pole South 49.47'
- Nail & tab in NW face 20" Oak N. 54° E. 69.79'
- Nail & Tab in NW face 16" Oak N. 70° E. 87.41'



Signed by Allen H. McMachen  
 Surveyor's Michigan License No. 16935

Date 10/9/98