

LAND CORNER RECORDATION CERTIFICATE

Filing Requirement of Act 74, Mich. P.A. 1970

STATE OF MICHIGAN  
 COUNTY OF KALAMAZOO  
 RECEIVED FOR RECORD  
 98 OCT 12 PM 1 29  
 GLENN - REGISTER

Register of Deeds Stamp & File Number

For corners in CITY OF PORTAGE Located In: \_\_\_\_\_ Corner Code # \_\_\_\_\_  
KALAMAZOO (County)

1. Public Land Survey	T	<u>3S.</u>	R	<u>11W.</u>	F-5
	T	_____	R	_____	_____
	T	_____	R	_____	_____
	T	_____	R	_____	_____
2. Property Controlling in Section	S	_____	T	_____	_____
	S	_____	T	_____	_____
3. Miscellaneous Property in Section	S	_____	T	_____	_____
	S	_____	T	_____	_____

4. Lot No. \_\_\_\_\_, Recorded Plat \_\_\_\_\_  
 5. Private Claims \_\_\_\_\_

6. IWM Job No. 30661

I, Allen H. McMachen, in a field survey on March 23, 1998  
 do hereby certify that under requirements of P.A. 74, Michigan P.A. of 1970, the corner points mentioned in lines 1 and 2 above were in conformance with regulations and rules therefore as required in the current manual of survey instructions of the United States Department of the Interior, Bureau of Land Management or by a decree of a Court of Law and/or that the corner points mentioned in lines 3, 4 and 5 above were in conformance with the rules of the Michigan Board of Professional Surveyors or by a Decree of a Court of Law; established, re-established, monumented, re-monumented, recovered, found as expressed below:

**NOTE: Not more than 4 corners, all in the same town and range, may be recorded on this certificate.**

A. Description of original monument and accessories and/or subsequent restoration:

1827 - Robert Clark, Jr., D.S., Set quarter Section post, Wh. Oak 11" S. 45° W. 28 lks., Wh. Oak 13" N. 58° E. 6½ lks..

1948 - Plat of "Ringdale" is recorded in Liber 17, Page 7 showing Section corner & a measure from S¼ corner West 1325.39' to 1/8 corner.  
1977 - Sewer was installed near centerline and removed corner.

B. Description of corner evidence found and/or method applied in restoring or reestablishing corner:


Found "PK" nail shaft. Position of found shaft was verified by monumentation within the 1948 plat. Measured West 2650.66' to SW corner. Dug below shaft & found second "PK" nail in old road directly below found shaft.

SURVEY &  
 REMONUMENTATION  
 NOV 25 1998  
 SECTION

C. Description of monument for corner and accessories established to perpetuate locating the position of the corner:

Found "PK" nail shaft is accepted as a careful and faithful reestablishment of the position of the original corner. Replaced found shaft with a 30" Harrison Monument with monument box over, Accessories:

- Nail & tab in SW face utility pole N. 54° W. 55.97'
- Nail & Tab in SE face utility pole N. 56° E. 55.36'
- Nail & tab in NE face utility pole S. 50° E. 54.61'
- SW corner of brick house (#830) N. 10° W. 59.05'

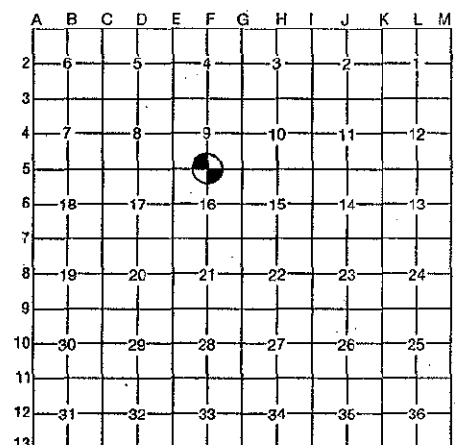

RATIFIED  
 BY KALAMAZOO COUNTY  
 REMONUMENTATION  
 PEER GROUP  
 5/21/98



Signed by Allen H. McMachen

Date 10/9/98

Surveyor's Michigan License No. 16935