

1993

LUCE COUNTY REMONUMENTATION CORNER

COMMISSION

LAND CORNER RECORDATION CERTIFICATE
Filing Requirement of Act 74, Mich. P.A. 1970

For corners in Luce

(County)	Located In:	Corner Code #
1. Public Land Survey	T <u>45N</u> R <u>9W</u>	D-7
	T _____ R _____	_____
	T _____ R _____	_____
	T _____ R _____	_____
2. Property Controlling in Section	S _____ T _____ R _____	_____
	S _____ T _____ R _____	_____
3. Miscellaneous Property in Sec.	S _____ T _____ R _____	_____
	S _____ T _____ R _____	_____

Filed 12-22 A.D., 1993

At 10:00 o'clock A. M.

File No. pg 470

Keith R. Waters
Luce County Reg. of Deeds

Register of Deeds Stamp & File Number

4. Lot No. _____, Recorded Plat _____
5. Private Claims _____

I, Keith R. Waters, in a field survey on November, 1993, do hereby certify that under requirements of P.A. 74, Michigan P.A. of 1970, the corner points mentioned in lines 1 and 2 above were in conformance with regulations and rules therefore as required in the current manual of survey instructions of the United States Department of the Interior, Bureau of Land Management or by a decree of a Court of Law and/or that the corner points mentioned in lines 3, 4 and 5 above were in conformance with the rules of the Michigan Board of Land Surveyors or by a Decree of a Court of Law; established, re-established, monumented, re-monumented, recovered, found as expressed below:

NOTE: Not more than 4 corners, all in the same town and range, may be recorded on this certificate.

A. Description of original monument and accessories and/or subsequent restoration:

D-7 1/4 Corner Common to Sections 17 & 20, T45N, R9W

Original ties to post:
Yellow Birch 12, S28°E 14 links
Yellow Birch 10, N33°W 28 links

B. Description of corner evidence found and/or method applied in restoring or reestablishing corner:

D-7

This corner is being perpetuated as part of the Luce County Remonumentation Program. Found a railroad spike in the approximate centerline of north-south gravel road (County Road 399) 33 west of a found "T" iron with cap #7873 on the extension of a fence line to the east. North-south position fits well with several fence and occupation lines on small parcels to the north on both sides of County Road 399. East-west position fits well with right-of-way fences to the north. Distance to established Section corner west is 2613.34 feet (GLO distance is 2625.48 feet). Accepted corner position as best available evidence. Replaced railroad spike with a 1/2" iron and 3/4" aluminum Luce County cap.


C. Description of monument for corner and accessories established to perpetuate locating the position of the corner:

D-7

Corner is a 1/2" rebar with 3/4" aluminum Luce County cap in the centerline of County Road 399. Witnesses:

- Power Pole (ML2-52-14), N47°E 32.26'
- 12" Cherry (Blazed), S66°E 78.40'
- 11" Balsam Fir (Not Blazed), S25°W 90.95'
- Power Pole (ML2-52-14-A), S69°W 36.72'

Note: Distances are to a nail and tag in the side of witness object. Bearings are compass bearings corrected for declination.

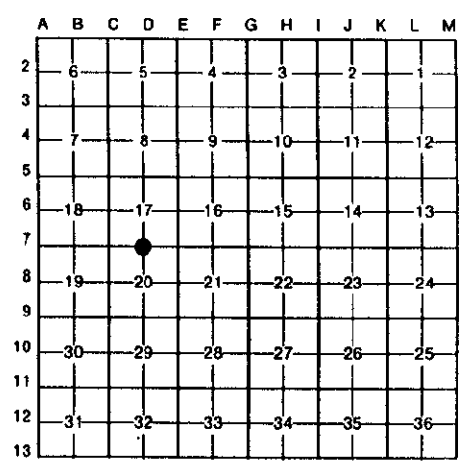

Signed by Keith R. Waters

Date 12-20-93

Surveyor's Michigan License No. 33142