

COMMISSION

LAND CORNER RECORDATION CERTIFICATE  
Filing Requirement of Act 74, Mich. P.A. 1970

For corners in Luce

(County)	Located In:	Corner Code #
1. Public Land Survey	T <u>45N</u> R <u>9W</u>	F-5
	T _____ R _____	_____
	T _____ R _____	_____
	T _____ R _____	_____
2. Property Controlling in Section	S _____ T _____ R _____	_____
	S _____ T _____ R _____	_____
3. Miscellaneous Property in Sec.	S _____ T _____ R _____	_____
	S _____ T _____ R _____	_____
4. Lot No. _____, Recorded Plat _____		
5. Private Claims _____		

Filed 12-22 A.D., 1993

At 10:00 o'clock A.M.

File No. 99 491

*Keith R. Waters*  
Luce County Reg. of Deeds

Register of Deeds Stamp & File Number

I, Keith R. Waters, in a field survey on December, 1993

do hereby certify that under requirements of P.A. 74, Michigan P.A. of 1970, the corner points mentioned in lines 1 and 2 above were in conformance with regulations and rules therefore as required in the current manual of survey instructions of the United States Department of the Interior, Bureau of Land Management or by a decree of a Court of Law and/or that the corner points mentioned in lines 3, 4 and 5 above were in conformance with the rules of the Michigan Board of Land Surveyors or by a Decree of a Court of Law; established, re-established, monumented, re-monumented, recovered, found as expressed below:

**NOTE: Not more than 4 corners, all in the same town and range, may be recorded on this certificate.**

A. Description of original monument and accessories and/or subsequent restoration:

F-5 1/4 Corner Common to Sections 9 & 16, T45N, R9W

Original ties to post:  
Sugar 10, N64°E 22 links  
Beech 4, S50°W 17 links

B. Description of corner evidence found and/or method applied in restoring or reestablishing corner:

F-5

This corner is being re-established as part of the Luce County Remonumentation Program. Found no evidence of corner. Re-established corner mid-way on line between section corners 2628.66 feet east and 2628.66 feet west. East-west position fits well with occupation lines on 2 acre and 6 acre parcels to the east, on the south side of Highway M-28.


C. Description of monument for corner and accessories established to perpetuate locating the position of the corner:

F-5

Corner is a 1/2" rebar with 3 1/4" aluminum Luce County cap 11 feet south of centerline of Highway M-28, approximately 18 feet east of centerline of gravel road to the south (County Road 397). Witnesses:

- 8" Sugar Maple, N50°W 86.02'
- 12" Spruce, NORTH 52.24'
- 26" Spruce, S34°E 41.12'
- Power Pole (ML2-64), S04°E 66.22'

Note: Distances are to a nail and tag in the side of witness object. Trees are blazed and painted. Bearings are compass bearings corrected for declination.

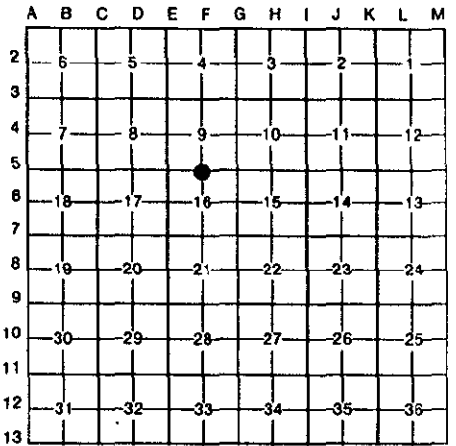

Signed by Keith R. Waters  
Surveyor's Michigan License No. 33142

Date 12/20/93