

MAY 28 1997

COMMISSION

LUCE COUNTY REMONUMENTATION CORNER

LAND CORNER RECORDATION CERTIFICATE

Filing Requirement of Act 74, Mich. P.A. 1970 LUCE COUNTY

For corners in

Luce _____
(County)

Located In:

Corner Code #

1. Public Land Survey

T46N R10W ✓ ~~D-12~~ Same
T47N R10W D-13 Corner

2. Property Controlling in Section

S _____ T _____ R _____

3. Miscellaneous Property in Sec.

S _____ T _____ R _____
S _____ T _____ R _____

4. Lot No. _____, Recorded Plat _____
5. Private Claims _____

I, Keith R. Waters, in a field survey on 12/10, 1996 do hereby state that under requirements of P.A. 74, Michigan P.A. of 1970, the corner points mentioned in lines 1 and 2 above were in conformance with regulations and rules therefore as required in the current manual of survey instructions of the United States Department of the Interior, Bureau of Land Management or by a decree of a Court of Law and/or that the corner points mentioned in lines 3, 4 and 5 above were in conformance with the rules of the Michigan Board of Land Surveyors or by a Decree of a Court of Law, established, re-established, monumented, recovered, found as expressed below:

NOTE: Not more than 2 corners, all in the same town and range, may be recorded on this certificate.

REGISTER OF DEEDS

Recorded


Liber 2 Page 706

02-28-1997 08:53:45

Kathy S. Mahar

Kathy S. Mahar, Register
REGISTER OF DEEDS

Register of Deeds Stamp & File Number

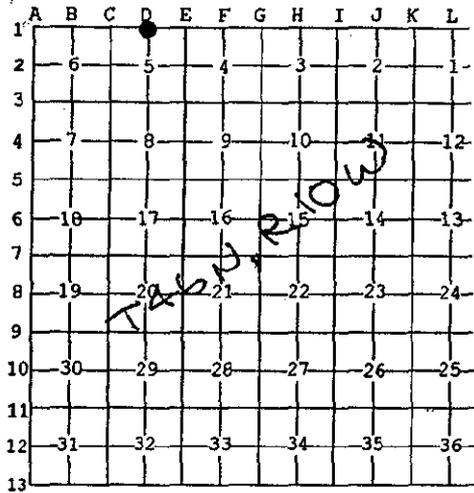

A. Description of original monument and accessories and/or subsequent restoration:

D-1 (D-13) 1/4 Corner Common to Section 5, T46N, R10W & Section 32, T47N, R10W

1841 - Original ties to set post (John Burt): Beech 12, N14°E 31 links - Beech 5, N45°W 26 links.

1960 - Billy D. Buckler, RLS 8887, page 409A of Luce County recorded corners. Corner re-established midway and on line between section corners. Found no evidence of original corner. Corner lies on south edge of road.

Witnesses: 6" Hard Maple, S25°E 73 links - 6" Hard Maple, S30°W 72½ links.

B. Description of corner evidence found and/or method applied in restoring or reestablishing corner:

This corner is being perpetuated as part of the Luce County Remonumentation Program.

Found a 1" iron pipe on the north side of a pointed top wooden post, on the south side of County Road. Also found Buckler's bearing tree to the southeast. Accepted corner as found and established new additional witness objects.

C. Description of monument for corner and accessories established to perpetuate locating the position of the corner:

Corner is 1" iron pipe on the north side of a pointed top wooden post, 35 feet south of the centerline of County Road 407. Witnesses:

10" Sugar Maple, S25°E 48.20' (existing bearing tree)

Power Pole, N18°W 67.81'

11" Sugar Maple, S03°E 29.57'

12" Sugar Maple, S29°W 45.92'

Note: Distances are to a nail/tag P.S. 33142 in the side of the witness object. Trees are blazed and painted.

Bearings are compass bearings corrected for declination.

Signed by Keith R. Waters

Date 12-30-96

Surveyor's Michigan License No. 33142

