

SURVEY & REMONUMENTATION

MAY 28 1997

COMMISSION

LUCE COUNTY REMONUMENTATION CORNER

LAND CORNER RECORDATION CERTIFICATE
Filing Requirement of Act 74, Mich. P.A. 1970

For corners in


Luce	Located In:	Corner Code #
(County)		
1. Public Land Survey	T46N R 10W	G-1 Same
	T47N R 10W	G-13 Corner
	T ___ R ___	_____
	T ___ R ___	_____
2. Property Controlling in Section	S ___ T ___ R ___	_____
	S ___ T ___ R ___	_____
3. Miscellaneous Property in Sec.	S ___ T ___ R ___	_____
	S ___ T ___ R ___	_____

LUCE COUNTY
REGISTER OF DEEDS
Recorded
Liber 2 Page 709
02-28-1997 08:54:10
Kathy S. Mahar
Kathy S. Mahar, Register
REGISTER OF DEEDS

Register of Deeds Stamp & File Number

4. Lot No. _____, Recorded Plat _____
5. Private Claims _____

I, Keith R. Waters in a field survey on 12/10 1996 do hereby state that under requirements of P.A. 74, Michigan P.A. of 1970, the corner points mentioned in lines 1 and 2 above were in conformance with regulations and rules therefore as required in the current manual of survey instructions of the United States Department of the Interior, Bureau of Land Management or by a decree of a Court of Law and/or that the corner points mentioned in lines 3, 4 and 5 above were in conformance with the rules of the Michigan Board of Land Surveyors or by a Decree of a Court of Law; established, re-established, monumented, recovered, found as expressed below:

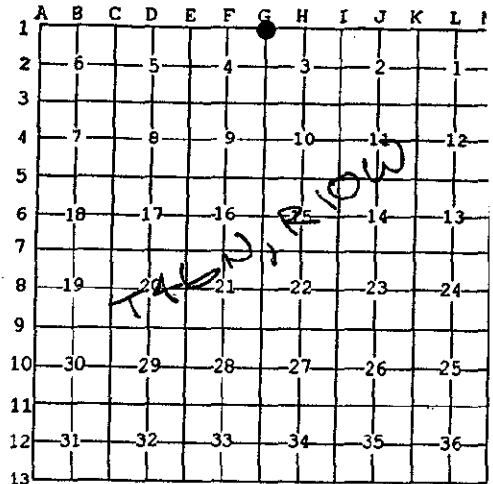

NOTE: Not more than 2 corners, all in the same town and range, may be recorded on this certificate.

A. Description of original monument and accessories and/or subsequent restoration:

G-1 (G-13) Corner Common to Sections 3 & 4, T46N, R10W & Sections 33 & 34, T47N, R10W

1841 - Original ties to set post (John Burt): Birch 12, N10°E 49 links - Birch 12, N58°W 23 links.


1964 - Frank J. Bray, RLS, page 569A of Luce County recorded corners. Corner re-established midway on line between 1/4 corners 1/2 mile east and west. Witnesses: 5" Soft Maple, S02°E 64 links - 5" Soft Maple, N04°E 62 links.

1994 - Stephan J. Szyszkoski, P.S. 33986, liber 2, page 629, Luce County recorded corners. Found and accepted Bray's 1964 monument at record bearing and distance from soft maple southeast. New witnesses: Fence Post, NORTH 40.3' - 5" Soft Maple, S02°E 42.5' - Power Pole (ML1-167), N40°E 43.2' - Power Pole Support, S40°E 41.45'.

B. Description of corner evidence found and/or method applied in restoring or reestablishing corner:

This corner is being perpetuated as part of the Luce County Remonumentation Program.

Found a large spike at surface of asphalt road, 3.5 feet north of centerline. Spike checks well with four found witness objects as shown in LCRC in liber 2, page 629. Accepted corner as found and placed a plastic cap #33142 on spike.

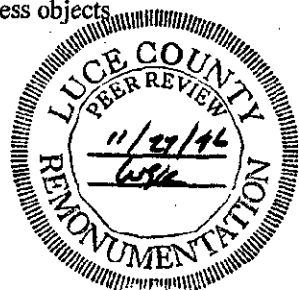

C. Description of monument for corner and accessories established to perpetuate locating the position of the corner:

Corner is a large spike with plastic cap #33142, 3.5 feet north of the centerline of County Road 407.

Witnesses:

5" Soft Maple, S02°E 42.36'

Fence Post, NORTH 40.24'

Power Pole (ML1-167), N40°E 43.14'

Power Pole Support, S40°E 41.45'

Note: Distances are to a nail and washer in the side of the witness object.

Bearings are compass bearings corrected for declination.



Signed by Keith R. Waters
Surveyor's Michigan License No. 33142

Date 12-30-96