

# SURVEY & REMONUMENTATION

APR 28 1995

COMMISSION

## LAND CORNER RECORDATION CERTIFICATE

Filing Requirement of Act 74, Mich. P.A. 1970

Macomb Twp.

For corners in Macomb

(County)

Located In: Corner Code #

		3N	13E	G-3		
1. Public Land Survey	T	_____	R	_____	_____	
	T	_____	R	_____	_____	
	T	_____	R	_____	_____	
	T	_____	R	_____	_____	
2. Property Controlling in Section	S	_____	T	_____	R	_____
	S	_____	T	_____	R	_____
3. Miscellaneous Property in Sec.	S	_____	T	_____	R	_____
	S	_____	T	_____	R	_____


94 DEC -9 **C150784**  
PM 2:49

CARMEL J. SCHAUGH  
REGISTER OF DEEDS  
MACOMB COUNTY, MI

LIBER **6523** PAGE **931**

Register of Deeds Stamp & File Number

4. Lot No. \_\_\_\_\_, Recorded Plat \_\_\_\_\_  
5. Private Claims \_\_\_\_\_

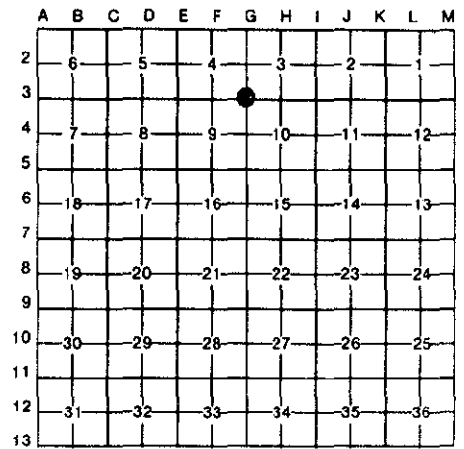

I, Robert D. Kohn, in a field survey on October 2, 1994, do hereby certify that under requirements of P.A. 74, Michigan P.A. of 1970, the corner points mentioned in lines 1 and 2 above were in conformance with regulations and rules therefore as required in the current manual of survey instructions of the United States Department of the Interior, Bureau of Land Management or by a decree of a Court of Law and/or that the corner points mentioned in lines 3, 4 and 5 above were in conformance with the rules of the Michigan Board of Land Surveyors or by a Decree of a Court of Law; established, re-established, monumented, re-monumented, recovered, found as expressed below:

**NOTE: Not more than 4 corners, all in the same town and range, may be recorded on this certificate.**

A. Description of original monument and accessories and/or subsequent restoration:

1817 Post	Notes	W. Preston	N/A	Notes
1972 1/2" Pipe	L.C.R.C.	H. Kobs	#14097	L2279 P385
1972 1/2" Pipe	Survey	H. Kobs	#14097	L2297 P392
1973 1/2" Pipe	L.C.R.C.	R. Smith	#16052	L2445 P720
1973 1/2" Pipe	Survey	R. Smith	#16052	L2445 P719
1974 1/2" Iron bar	L.C.R.C.	J. Buckerfield	#10868	L2544 P224
1977 1/2" Pipe	Survey	H. Kobs	#14097	L2775 P795
1979 1/2" Pipe	Survey	K. Thompson	#16054	L3125 P795
1992 1/2" Pipe	Survey	R. Stecker	#30103	L5769 P188
1993 1/2" Pipe	L.C.R.C.	R. Stecker	#30103	L5767 P679

B. Description of corner evidence found and/or method applied in restoring or reestablishing corner:

A 1/2" iron pipe being 1.0' ± south of the centerline of existing asphalt pavement and 3.0' ± west of the centerline of a gravel road to the north currently marks this corner. The following witness ties were used to recover and verify its positions:

- 2 ties from L.C.R.C. L2279 P385
- 1 tie from L.C.R.C. L2445 P720
- 4 ties from L.C.R.C. L5767 P679

Field measurements were made between the following corners:

F-3 to G-3	2682.46	meas.	G.L.O.	Notes
	2646.60	rec.		
G-3 to G-4	2672.86	meas.	G.L.O.	Notes
	2640	rec.		
G-3 to H-3	2693.51	meas.	G.L.O.	Notes
	2656.50	rec.		
	2693.53	rec.	L5769 P188	Survey


ACCEPTED BY THE MACOMB COUNTY SURVEY PEER GROUP AS THE OFFICIAL CORNER UNDER MICHIGAN PUBLIC ACT 345 OF 1990 AT A MEETING HELD ON 10-18-94

*William E. Soderberg*  
WILLIAM E. SODERBERG, P.S., CHAIRMAN

C. Description of monument for corner and accessories established to perpetuate locating the position of the corner:

I replaced the 1/2" iron rod with a 3/4" x 24" iron rod with 2" diameter aluminum cap stamped "Macomb County Monument MI Act 345 #26459" in new monument box.

- N.58° W. 50.83' Set P.K. and remon. tag in S.W. face of utility pole
- N.28° W. 91.15' Set P.K. and remon. tag in east face of utility pole
- N.22° E. 103.22' Set P.K. and remon. tag in west face of 10" Oak
- S.14° E. 21.50' Set P.K. and remon tag in east face of Elm clump

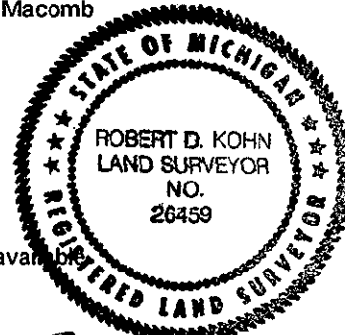

The selected location is accepted by me and generally accepted by Professional Surveyors as the best available evidence of the position of the original corner.

Signed by Robert D. Kohn Date NOVEMBER 9, 1994

Surveyor's Michigan License No. 26459