

SURVEY & REMONUMENTATION

APR 28 1995

COMMISSION

LAND CORNER RECORDATION CERTIFICATE Filing Requirement of Act 74, Mich. P.A. 1970

C150791

LIBER 6523 PAGE 938

94 DEC -9 PM 2:49

CARMEL L. BAUGH
REGISTER OF DEEDS
MACOMB COUNTY, MI

For corners in Macomb

Macomb Twp.

	(County)	Located In:		Corner Code #
		3N	13E	
1. Public Land Survey		T	R	H-5
		T	R	
		T	R	
		T	R	
2. Property Controlling in Section	S	T	R	
	S	T	R	
3. Miscellaneous Property in Sec.	S	T	R	
	S	T	R	

Register of Deeds Stamp & File Number

4. Lot No. _____, Recorded Plat _____
5. Private Claims _____


Robert D. Kohn

August 8

94

I, _____, in a field survey on _____, 19 _____, do hereby certify that under requirements of P.A. 74, Michigan P.A. of 1970, the corner points mentioned in lines 1 and 2 above were in conformance with regulations and rules therefore as required in the current manual of survey instructions of the United States Department of the Interior, Bureau of Land Management or by a decree of a Court of Law and/or that the corner points mentioned in lines 3, 4 and 5 above were in conformance with the rules of the Michigan Board of Land Surveyors or by a Decree of a Court of Law; established, re-established, monumented, re-monumented, recovered, found as expressed below:

NOTE: Not more than 4 corners, all in the same town and range, may be recorded on this certificate.

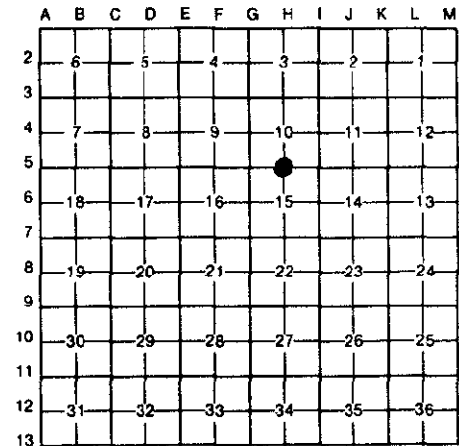

A. Description of original monument and accessories and/or subsequent restoration:

Date	Description	G.L.O.	Surveyor	Notes	Notes
1817	Post	G.L.O.	W. Preston	N/A	
1973	1/2" Bar	L.C.R.C.	H. Avey	#15396	L2426 P339
1975	Iron	Survey	F. Bridges	#5779	L2719 P412
1977	1/2" Iron bar	L.C.R.C.	H. Kobs	#14097	L2923 P873
1978	Iron	Survey	R. Smith	#16052	L2963 P397
1979	1/2" Solid steel stake	L.C.R.C.	W. Carlson	#14759	L3327 P526
1980	1/2" Iron bar	Survey	H. Kobs	#14097	L3217 P703
1990	1/2" Iron	L.C.R.C.	J. Fenn	#23505	L4810 P939

B. Description of corner evidence found and/or method applied in restoring or reestablishing corner:

A 1/2" iron rod in asphalt pavement currently marks the location of this corner. The following witness ties were used to recover and verify its position:

2 ties from L.C.R.C. L3327 P526
3 ties from L.C.R.C. L4810 P939

Field measurements were made between the following corners:

H-5 to G-5	2695.91	meas.		
	2649.90	G.L.O.		
	2695.21	rec.	L2963 P397	Survey
	2695.80	rec.	L2719 P412	Survey
H-5 to I-5	2665.38	meas.		
	2649.90	G.L.O.		
	2665.64	rec.	L3217 P703	Survey


ACCEPTED BY THE MACOMB COUNTY SURVEY PEER GROUP AS THE OFFICIAL CORNER UNDER MICHIGAN PUBLIC ACT 345 OF 1990 AT A MEETING HELD ON 9-27-94

William E. Soderberg
WILLIAM E. SODERBERG, P.S., CHAIRMAN

C. Description of monument for corner and accessories established to perpetuate locating the position of the corner:

I replaced the 1/2" iron rod with a 3/4" x 24" iron rod with 2" diameter aluminum cap stamped "Macomb County Monument MI Act 345 #26459" in a new monument box.

N.64° E.	50.51'	P.K. nail and remon. tag W. face U-pole
S.71° W.	96.70'	Center monitoring well
N.71° W.	71.78'	Chiseled " + " N. rim gate valve
N.22° W.	72.26'	Chiseled " + " N. rim gate valve

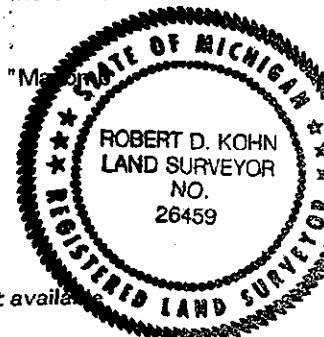

The selected location is accepted by me and generally accepted by Professional Surveyors as the best available evidence of the position of the original corner.

Signed by

Robert D. Kohn

Surveyor's Michigan License No. 26459

Date

NOVEMBER 9, 1994