

**SURVEY &  
REMONUMENTATION**

MAR 10 95 040424

MAY - 1 1995

LIBER 15288 PG 510

**COMMISSION**

**LAND CORNER RECORDATION CERTIFICATE**

Filing Requirement of Act 74, Mich. P.A. 1970

Commerce Twp.

7.00 MISC RECORDING CHG - IN HOUSE  
2.00 REMON CHG - IN HOUSE  
10 MAR 95 4:02 P.M. RECEIPT# 1778  
PAID RECORDED - OAKLAND COUNTY  
LYNN D. ALLEN, CLERK/REGISTER OF DEEDS

For corners in Oakland  
(County)

Located In: \_\_\_\_\_ Corner Code # \_\_\_\_\_

- |                                    |                         |            |
|------------------------------------|-------------------------|------------|
| 1. Public Land Survey              | T <u>2N</u> R <u>8E</u> | <u>I-4</u> |
|                                    | T _____ R _____         | _____      |
|                                    | T _____ R _____         | _____      |
|                                    | T _____ R _____         | _____      |
| 2. Property Controlling in Section | S _____ T _____ R _____ | _____      |
|                                    | S _____ T _____ R _____ | _____      |
| 3. Miscellaneous Property in Sec.  | S _____ T _____ R _____ | _____      |
|                                    | S _____ T _____ R _____ | _____      |

Compliance with ACT 345, P.A. 1990  
APPROVED ON: 12-5-94  
OAKLAND COUNTY REMONUMENTATION PEER GROUP COMMITTEE  
**OK - T SMITH**  
Register of Deeds Stamp & File Number

4. Lot No. \_\_\_\_\_, Recorded Plat \_\_\_\_\_  
5. Private Claims \_\_\_\_\_


David Pawlaczyk

November 29

94

I, \_\_\_\_\_, in a field survey on \_\_\_\_\_, 19 \_\_\_\_\_, do hereby certify that under requirements of P.A. 74, Michigan P.A. of 1970, the corner points mentioned in lines 1 and 2 above were in conformance with regulations and rules therefore as required in the current manual of survey instructions of the United States Department of the Interior, Bureau of Land Management or by a decree of a Court of Law and/or that the corner points mentioned in lines 3, 4 and 5 above were in conformance with the rules of the Michigan Board of Land Surveyors or by a Decree of a Court of Law; established, re-established, monumented, re-monumented, recovered, found as expressed below:

**NOTE: Not more than 4 corners, all in the same town and range, may be recorded on this certificate.**

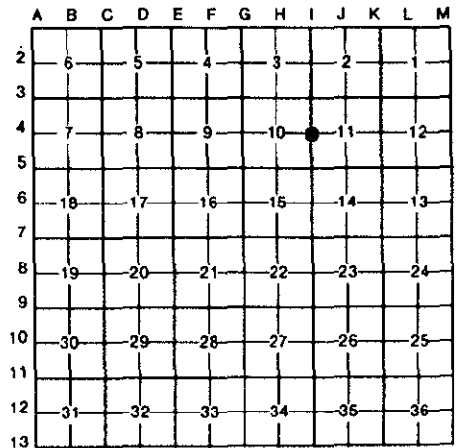

**A. Description of original monument and accessories and/or subsequent restoration:**

					Notes
1815	Post	G.L.O.	A. Holmes	N/A	
1987	Iron in monument box	Survey	J. Bishop	#25829	L10065 P264
1988	Iron in monument box	L.C.R.C.	K. Stevenson	#29253	L10555 P362

**B. Description of corner evidence found and/or method applied in restoring or reestablishing corner:**  
A 1 1/2" iron rod in a monument box in asphalt pavement being  $\pm$  6' south of centerline currently occupies this corner. The following witness ties were used to recover and verify its position.

3 ties from L.C.R.C. L10555 P362  
2 ties from witness/survey L11036 P310

M. Baldwin ties from county records confirm location with mon. box being  $\pm$  6' south of centerline and an old fence post S.50° E., 82.0'.

Field measurements were made between the following corners:

I-4 to H-4	2630.27	meas.		
I-4 to I-3	2640.27	meas.		
	2640.00	rec.	G.L.O.	Notes
	2640.30	rec.	Survey	L10065 P264
I-4 to J-4	2670.89	meas.		
I-4 to I-5	2631.04	meas.		
	2640.00	rec.	G.L.O.	Notes

**C. Description of monument for corner and accessories established to perpetuate locating the position of the corner:**

I replaced the 1" rod with a 5/8" x 24" iron rod with a 2" diameter brass cap stamped "Oakland County Remonumentation PS #17632" in an existing monument box in asphalt pavement.

N.55° W.	64.34'	P.K. nail and O.C.R. tag S. face guy pole
N.44° E.	41.74'	To centerline sanitary manhole
S.61° E.	61.93'	P.K. nail and O.C.R. tag in N.E. face D.E. pole
S.73° W.	92.45'	P.K. nail and O.C.R. tag in N. face D.E. pole

The selected location is accepted by me and generally accepted by Professional Surveyors as the best available evidence of the position of the original corner.

Signed by [Signature]

Date 2-16-95

Surveyor's Michigan License No. 17632

