

FEB 24 2000

RECORDED

99 SEP -9 PM 12: 15

OTTAWA COUNTY REMONUMENTATION
LAND CORNER RECORDATION CERTIFICATE
Filing Requirement of Act 74, Mich. P.A. 1970

SECTION

For corners in

Ottawa

(County)

Located In:

Corner Code #

1. Public Land Survey

T8N R 14W

D-3 (N $\frac{1}{4}$, 8)

Polkton Twp.

2. Property Controlling
In Section

S

T

R

3. Miscellaneous
Property in Sec.

S

T

R

S

T

R

Dany Schiele
REGISTER OF DEEDS
OTTAWA COUNTY, MI


Register of Deeds Stamp & File Number

4. Lot No. _____, Recorded Plat _____

5. Private Claims _____

I, Donald W. Schiele, in a field survey on Aug. 30, 1999 do hereby state that under requirements of P.A. 74, Michigan P.A. of 1970, the corner points mentioned in lines 1 and 2 above were in conformance with regulations and rules therefore as required in the current manual of survey instructions of the United States Department of the Interior, Bureau of Land Management or by a decree of a Court of Law and /or that the corner points mentioned in lines 3, 4 and 5 above were in conformance with the rules of the Michigan Board of Land Surveyors or by a Decree of a Court of Law; established, re-established, monumented, recovered, found as expressed below.

NOTE: Not more than 2 corners, all in the same town and range, may be recorded on this certificate.

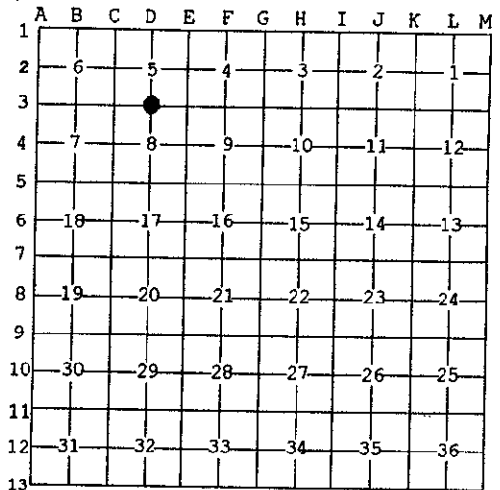

A. Description of original monument and accessories and/or subsequent restoration:

D-3 1/4 corner common to Sections 5 & 8, Polkton Twp.

Original Government Corner Record:

Ottawa County Surveyor Records, 3-25-1889 by

Set qr section post

E.H. Peck:

Post

D-3 Found stone

Sugar 8 N32W 13

Do 12 S E 31

John Mullett, Deputy Surveyor

(SEE REVERSE)

April 15, 1837

8/30/99
YDZ

B. Description of corner evidence found and/or method applied in restoring or reestablishing corner:

D-3 Found 1/2" X 18" Capped Iron #18987, 10" below surface of gravel road, and accepted as a careful and faithful perpetuation of the position of the original corner. Found 7" X 5" stone on West edge of Capped Iron # 18987.

Found Ottawa County Remon Tag & nail in NE side of 6" Elm S62°E 65.46'(E)

Found Ottawa County Remon Tag & nail in NE side of 7" Elm S40°30'E 51.21'(E)

Found Ottawa County Remon Tag & nail in West side of Power Pole S01°E 81.01'(E)

Found Ottawa County Remon Tag & nail in East side of Power Pole N01°30'W 117.96'(E)

C. Description of monument for corner and accessories established to perpetuate locating the position of the corner:

D-3 Removed 1/2" X 18" Capped Iron #18987 and replaced with 3/4" X 24" Steel Bar with Ottawa County Remon Cap, 6" below surface of gravel road. Replaced 7" X 5" stone along West edge of Remon Cap.

Found Ottawa County Remon Tag & nail in NE side of 6" Elm S62°E 65.46'(E)

Found Ottawa County Remon Tag & nail in NE side of 7" Elm S40°30'E 51.21'(E)

Found Ottawa County Remon Tag & nail in West side of Power Pole S01°E 81.01'(E)

Found Ottawa County Remon Tag & nail in East side of Power Pole N01°30'W 117.96'(E)

On centerline East & West gravel road.


Pole line to North, 3' West

Pole line to South, 0.4' East

(SEE SKETCH ON REVERSE)

\$11.00 CORNER
RECEIVED \$56820
\$2.00 PHOTO
RECEIPT #56820

Signed by Donald W. Schiele
Surveyor's Michigan License No. 23517

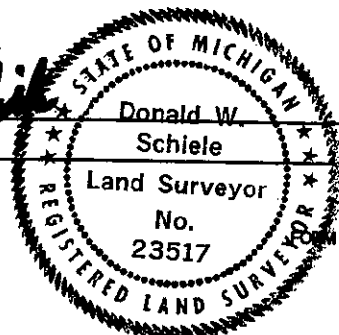

Date August 30, 1999

Part A., continued:

From field notes, Milanowski & Englert Engineering and Surveying, Inc., 1998:
D-3 S 1/4 Cor Witness Ties to Found Stone, replaced with Capped Iron #18987:

Nail & tag in E. side PP	358°53'30"	117.95'
N & T in N. side 4" Elm	117°18'53"	65.42'
N & T in NE side 5" Elm	138°44'30"	51.17'
N & T in W. side PP	179°47'58"	80.97'

FEB 24 2000

SECTION

