

FEB 24 2000

RECORDED

99 SEP 23 PM 3: 22

SECTION

OTTAWA COUNTY REMONUMENTATION  
LAND CORNER RECORDATION CERTIFICATE  
Filing Requirement of Act 74, Mich. P.A. 1970

*Ray Sublett*  
REGISTER OF DEEDS  
OTTAWA COUNTY, MI

For corners in

<u>Ottawa</u> (County)	Located In:	Corner Code #
	Crockery Township	
1. Public Land Survey	T 8N R 15W	J-1
	T ___ R ___	N 1/4 corner
	T ___ R ___	Section 2
	T ___ R ___	_____
2. Property Controlling in Section	S ___ T ___ R ___	_____
	S ___ T ___ R ___	_____
3. Miscellaneous Property in Sec.	S ___ T ___ R ___	_____

Register of Deeds Stamp & File Number

4. Lot No. \_\_\_\_\_, Recorded Plat \_\_\_\_\_  
5. Private Claims \_\_\_\_\_

I, Carl P. Englert, in a field survey on 5/27, 19 99 do hereby state that under requirements of P.A. 74, Michigan P.A. of 1970, the corner points mentioned in lines 1 and 2 above were in conformance with regulations and rules therefore as required in the current manual of survey instructions of the United States Department of the Interior, Bureau of Land Management or by a decree of a Court of Law and /or that the corner points mentioned in lines 3, 4 and 5 above were in conformance with the rules of the Michigan Board of Land Surveyors or by a Decree of a Court of Law; established, re-established, monumented, recovered, found as expressed below:

NOTE: Not more than 2 corners, all in the same town and range, may be recorded on this certificate.

	A	B	C	D	E	F	G	H	I	J	K	L	M
1													
2	6		5		4		3		2		1		
3													
4	7		8		9		10		11		12		
5													
6	18		17		16		15		14		13		
7													
8	19		20		21		22		23		24		
9													
10	30		29		28		27		26		25		
11													
12	31		32		33		34		35		36		
13													

A. Description of original monument and accessories and/or subsequent restoration:

J-1 No corner set, J-13, T9N, R15W Set by John Mullett, 1837 Common to J-1, T8N, R15W Set 1/4 Section Post Hemlock 6" N82°E 31 Links Hemlock 7" N30°W 40 Links	Muskegon County Tie Book Lewandoski No Date 3/4" Iron SE 33.70' 6" Pine S 28.12' Fence Post NNW 29.42' 40" Maple
---	---

See Other Side

B. Description of corner evidence found and/or method applied in restoring or reestablishing corner:

J-1 Found 3" Broken Cast Iron Monument in Mon. Box 12 inches deep  
in centerline of Asphalt Road on Fence Lines North and South  
Found 40" Maple N34°W  
Found Base of Fence Post 28'±  
Found 10" Pine N45°E 53.93'

Accepted as a careful and faithful perpetuation of the original position of the corner.

C. Description of monument for corner and accessories established to perpetuate locating the position of the corner:

J-1 3" Harrison Cast Iron Monument with Broken Top in Mon. Box  
O.C. Remon Tag and Nail in SW Side 40" Maple N34°W 31.37'  
O.C. Remon Tag and Nail in E Side Power Pole N 1°E 55.86'  
O.C. Remon Tag and Nail in SE Side 10" Red Pine N39°E 53.98'  
O.C. Remon Tag and Nail in NE Side 9" Cherry S37°E 44.79'

Signed by Carl P. Englert  
Surveyor's Michigan License No. 18987

Date 8/13/1999



FEB 24 2000

SECTION

J-1 T8N, R15W

LCRC Liber 2, Page 5 Englert, January, 1973

Set 1" Pipe on Centerline of Road and on Fence Line North and South

NW 29.45' 40" Maple

NE 29.6' 6" Pine

SE 33.65' 8" Pine

SW 46.58' 6" Aspen

LCRC Liber 2, Page 59 Englert, February, 1973

Found 1" Pipe

Ties same as Liber 2, Page 5

LCRC Liber 4, Page 242 Joiner, November, 1981

Found 1" Pipe, Set Cast Iron Monument

40" Maple NW 29.48'

6" Pine NE 29.52'

8" Pine SE 33.61'

6" Aspen SW 46.55'

LCRC Liber 1810, Page 26, Muskegon County Remon. Records,  
Recorded as J-13, T9N, R15W, By Mr. Vallier, December, 1994

Found 4" Cast Iron Monument with County Surveyor Cap in Mon. Box

N27°W 31.29' Nail in N. Side 20-40" Tw. Maple

S51°W 57.00' Nail in N. Side 14" Red Pine


S20°W 41.38' Nail in E. Side 6" Poplar

S31°E 57.11' Nail in S. Side 12" R. Pine

N45°E 53.93' Nail in S. Side 10" Pine

T9N, R15W

Sec. 35

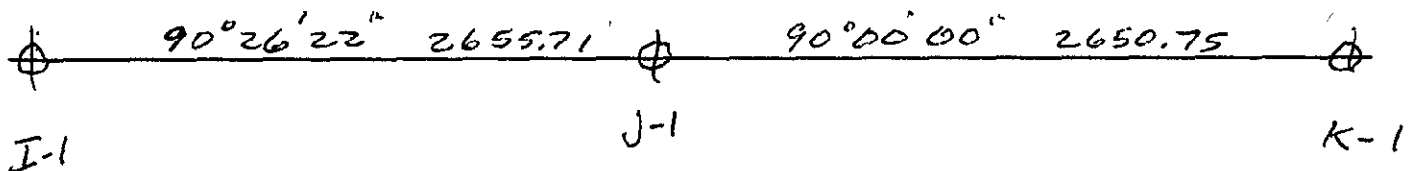

T8N, R15W

Sec 2