

FEB 24 2000

RECORDED

99 SEP 23 PM 3:21

SECTION

OTTAWA COUNTY REMONUMENTATION
LAND CORNER RECORDATION CERTIFICATE
Filing Requirement of Act 74, Mich. P.A. 1970

Sam Schellton
REGISTER OF DEEDS
OTTAWA COUNTY, MI

For corners in

Ottawa

(County)

Located In: Crockery Township
Corner Code #

- 1. Public Land Survey T 8N R 15W K-1
 T R NW Corner
 T R Section 1
 T R _____
- 2. Property Controlling S T R _____
 in Section S T R _____
- 3. Miscellaneous S T R _____
 Property in Sec. S T R _____

Register of Deeds Stamp & File Number

- 4. Lot No. _____, Recorded Plat _____
- 5. Private Claims _____

I, Carl P. Englert, in a field survey on 5/27, 1999 do hereby state that under requirements of P.A. 74, Michigan P.A. of 1970, the corner points mentioned in lines 1 and 2 above were in conformance with regulations and rules therefore as required in the current manual of survey instructions of the United States Department of the Interior, Bureau of Land Management or by a decree of a Court of Law and/or that the corner points mentioned in lines 3, 4 and 5 above were in conformance with the rules of the Michigan Board of Land Surveyors or by a Decree of a Court of Law; established, re-established, monumented, recovered, found as expressed below:

NOTE: Not more than 2 corners, all in the same town and range, may be recorded on this certificate.

A	B	C	D	E	F	G	H	I	J	K	L	M
1												
2	6	5	4	3	2	1						
3												
4	7	8	9	10	11	12						
5												
6	18	17	16	15	14	13						
7												
8	19	20	21	22	23	24						
9												
10	30	29	28	27	26	25						
11												
12	31	32	33	34	35	36						
13												

A. Description of original monument and accessories and/or subsequent restoration:
 K-1 Corner Common to Sections 1 and 2, T8N, R15W & Sections 35 and 36, T9N, R15W
 Mr. Mullett states North between Sections 1 and 2 and intersected North Line at Post
 Set Post Corner Sections 35 & 36, T9N, R15W
 Beech 18" N65°E 41 Links
 Beech 10" N35°W 19 Links
 John Mullett 1837
 See Other Side
 Muskegon County Tie Book
 Iron 1950's
 SE 43.23' G Street Sign
 NE 87.55' P.P.
 SW 47.51' T.P.

B. Description of corner evidence found and/or method applied in restoring or reestablishing corner:
 K-1 Found Cast Iron Monument in Mon. Box (Broken Top) in centerline
 E-W and N-S Roads
 Found Power Pole N38°E 87.52'

Accepted as a careful and faithful perpetuation of the original position of the corner.


8/16/99
YDN

C. Description of monument for corner and accessories established to perpetuate locating the position of the corner:
 K-1 4" Harrison Cast Iron Monument with Broken Top in Mon. Box
 O.C. Remon Tag and Nail in West Side Power Pole S15°E 212.53'
 O.C. Remon Tag and Nail in South Side 10" White Pine N71°E 128.26'
 O.C. Remon Tag and Nail in SE Side Power Pole N38°E 87.52'
 O.C. Remon Tag and Nail in West Side 6" Red Pine N18°W 120.49'

RECEIVED
\$11.00
Receipt

Signed by Carl P. Englert Jr
Surveyor's Michigan License No. 18987

Date 8/13/1999

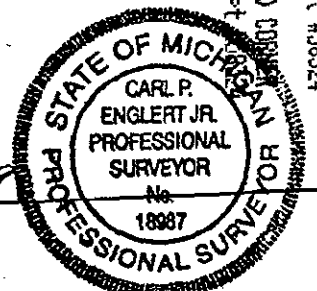

FEB 24 2000

SECTION

K-1, T8N, R15W

LCRC Liber 2, Page 251, Englert, August 1973
Found 1/4"x3" Iron
NE 87.67' P.P.
SE 41.42' St. sign
SW 47.53' T.P.

LCRC Liber 4, Page 242, Joiner, November 1981
Found Iron Spring Leaf, Set Cast Iron Monument
Power Pole NE 87.59'
St. Sign SE 43.23'
Tele. Box SW 46.74'
12" Pine NNE 106.58'


LCRC Liber 1242, Page 318 Muskegon County Records
Recorded as K-13, T9N, R15W by Lewandoski, July, 1982
Found Cast Iron Monument
N40°E 87.55' P. Pole
S40°E 43.23' Centerline of Street Sign
S48°W 47.51' T. Pole

LCRC Liber 1810, Page 563, Muskegon County Records
Recorded as K-13, T9N, R15W by Mr. Vallier, June 1994
Found 4" Cast Iron Monument
N40°E 87.55' Power Pole with Nail
S40°E 43.23' Street Sign
S48°W 47.51' T. Pole

T9N, R15W

Sec 35

Sec 36

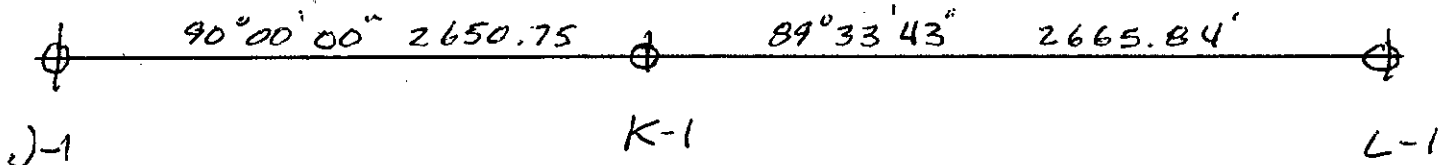

Sec. 2

Sec 1

T8N, R15W