

APR 05 1996

LAND CORNER RECORDATION CERTIFICATE
 COMMISSION Filing Requirement of Act 74, Mich. P.A. 1970

For corners in Wayne Co. (County) Located in: City of Riverview Corner Code # _____


1. Public Land Survey	T <u>4 S</u>	R <u>10 E</u>	<u>K-5</u>
	T _____	R _____	_____
	T _____	R _____	_____
	T _____	R _____	_____
2. Property Controlling in Section	S _____	T _____	R _____
	S _____	T _____	R _____
3. Miscellaneous Property in Sec.	S _____	T _____	R _____
	S _____	T _____	R _____

LIBER 28451 PAGE 500

Compliance with ACT 345, P.A. 1990
 APPROVED ON: 11-28-95 *J.P.L.*
 WAYNE COUNTY REMONUMENTATION PEER GROUP COMMITTEE
 Register of Deeds Stamp & File Number

4. Lot No. _____, Recorded Plat _____
 5. Private Claims _____

I, Randy Kolehouse, in a field survey on Nov. 3 19 95, do hereby certify that under requirements of P.A. 74 Michigan P.A. of 1970, the corner points mentioned in lines 1 and 2 above were in conformance with regulations and rules therefore as required in the current manual of survey instructions of the United States Department of the interior, Bureau of Land Management or by a decree of a Court of Law and/or that the corner points mentioned in lines 3, 4 and 5 above were in conformance with the rules of the Michigan Board of Land Surveyors or by a Decree of a Court of Law; established, re-established, monumented, re-monumented, recovered, found as expressed below:

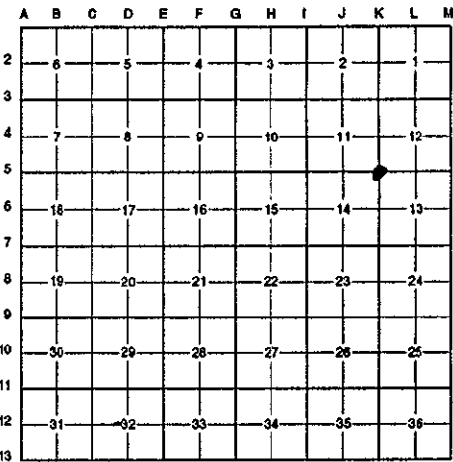

NOTE: Not more than 4 corners, all in the same town and range, may be recorded on this certificate.

A. Description of original monument and accessories and/or subsequent restoration:

K-5	1815	GLO	Notes	Post
	1930's	WPA	Unknown	Mon.
	1973	L.C.R.C.	Cantrell #5782	Monument in handhole
	1973	Cert. Survey	Arthurs #11358	Not stated
	1984	Cert. Survey	Ensminger #21268	Not stated
	1986	Cert. Survey	Shepherd #31605	Not stated

95262455

B. Description of corner evidence found and/or method applied in restoring or reestablishing corner:

K-5 I found the remains of monument and box at the centerline of King Rd.(concrete). Reestablished corner from ties to corner from Trenton King Estates Sub. (L.100,P.20). Which agrees with the following: \$ 7.00 DEED

L.C.R.C. L. 18648, P. 651/652
 PK nail in West side D.E. Pole N 0°08'00" E 52.62'
 Top of nut on hydrant S 46°48'00" E 68.00'

\$ 4.00 REMONUMENTATION
 8 DEC 95 12:38 P.M. RECEIP
 RECORDED
 FOREST E. YOUNGBLOOD, REGISTER
 WAYNE COUNTY, MI

EDS


Cert. Survey L. 21900, p. 585-587
 Fire hydrant Az. 48°50'07" 77.88'
 Fire hydrant Az 132°31'42" 67.40'

Measures east to L-5 T4S,R10E = 2604.26' (GLO = 2627.79'),(WPA =2606.11'sec.12, 2605.96'sec.13)
 Measures west to NE 1/16 cor Sec. 14 T4S,R10E = 1293.34' (C.S. L.18612,P.804/805=1292.27'),(C.S. L.21900,P.585=1293.47')
 Measures west to J-5 T4S,R10E = 2622.78' (GLO = 2641.32'),(WPA = 2624.51'sec.10, 2624.82'sec.14)

C. Description of monument for corner and accessories established to perpetuate locating the position of the corner:

K-5 I set a 2" aluminum cap stamped "Wayne County Remonumentation #25854" on a 1/2" rebar in a new monument box.

PK nail W. face P. pole	N6°E	52.73'
Top nut fire hydrant	N58°E	77.98'
Top nut fire hydrant	S40°E	67.55'
PK Nail in E face 10" Oak	S14°W	61.72'

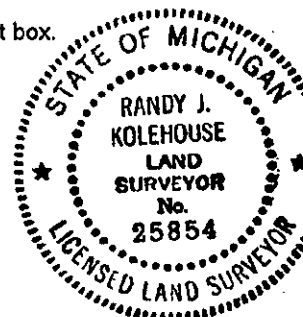

The selected location is accepted by the Contractor and is generally accepted by professional surveyors as the best available evidence of the position of the original corner.

Signed by Randy J. Kolehouse Date 12/2/95
 Surveyor's Michigan License No. 25854