Re Survey

Township N.o 25 N. Range N.o 9 E. Mer. Mich

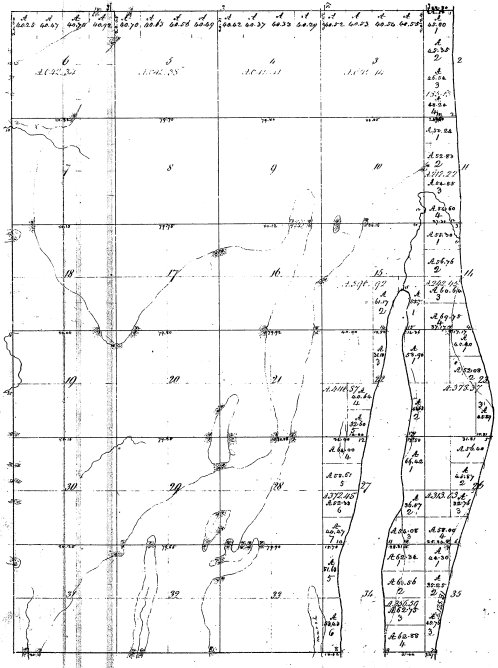

L. Huron.

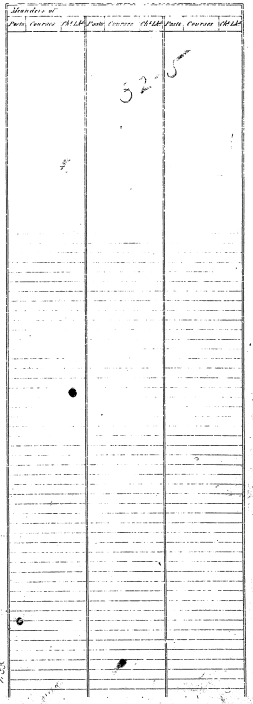

Surveys Designated	By Whom Surveyed	Date of Contract	Amount of Surveys at Old Rates	Whn. Surveyed	When Charged in the Surr Gen.l Off.
Township lines	T. Rice C. Cram	Aug. 10. 1833	14 ms. 87 ch.	2d qr. 1835	1st qr. 1839
Subdivisions	Mulliken & Hunt	May 27 1843	58 ms. 14 ch.	3d qr. 1843	4th qr. 1843

Total number of Acres 16,557.64

The above Map of Township No. 25 N. of Range No. 9 East of the Principal Meridian, Michigan, is strictly conformable to the field notes of the Surveys returned into this Office, which have been examined and approved.

Surveyor Generals Office, Cincinnati Nov. 25. 1843.

William Johnston
Surr Genl