Re survey

Township N.o 26 N. Range N.o 6 W. Mer. Mich.

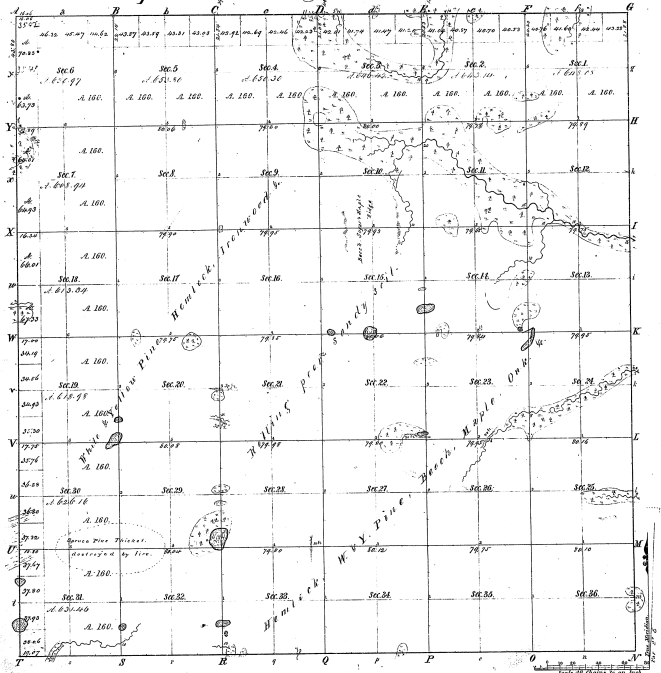

Meanders of

Posts	Courses	&c. &c.	Posts	Courses	&c. &c.	Posts	Courses	&c. &c.

22-18

Total number of Acres. 22971.50

Surveys Designated	By Whom Surveyed	Date of Contract	Amount of Surveys	When Surveyed	When approved and sent to the Surr Gen.l Office
			M. Ch.s Lks.		
Township lines	Thomas Rutherford	July 20.th 1827		8.th of Sept.r 1828	
Subdivisions	Joel D. Mullett	4.th of Jan.y 1836	71. 28	8.th of Sept.r 1846	

The above Map of Township N.o 26 North of Range N.o 6 East of the Principal Meridian Michigan is strictly conformable to the field notes of the survey thereof on file in this Office, which have been examined and approved.

Surveyor Generals Office. Lucius Lyon Surr.r Gen.l

Detroit Aug.st 1.st 1846