Mullett & Burt 22-8

Resurvey

Township No. 26 N. Range No. 8 E (Mich.) Mer.

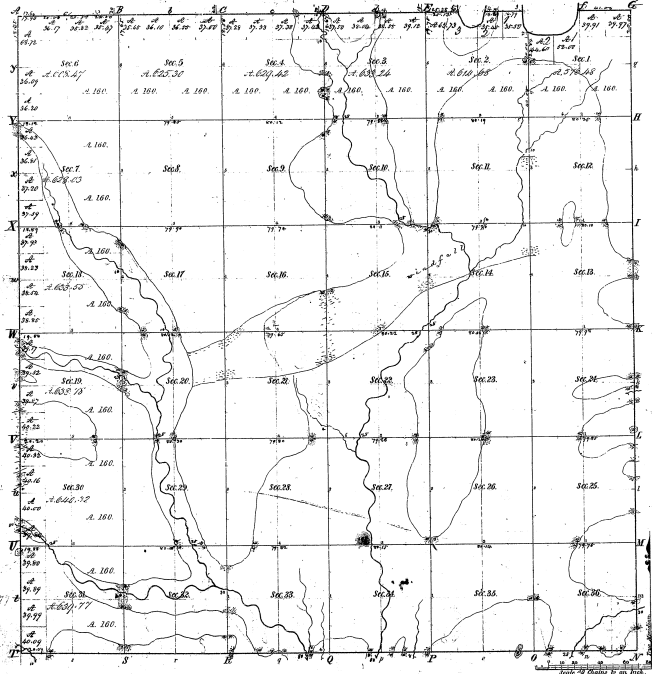

Meanders of								
Posts	Courses	Ch. Lk.	Posts	Courses	Ch. Lk.	Posts	Courses	Ch. Lk.

22-20

Total number of Acres. 22,868.04

Surveys Designated	By Whom Surveyed	Date of Contract	Amount of Surveys	When Surveyed	When pr. Ser. and ch. in the Surv. Gen. Ser.
Township lines	Lewis Adams	July 10th 1823	23 . 76 . 62	3rd Qr. 1823	4th Qr. 1823
Subdivisions	Mullett & Burt	May 17th 1823	60 . 78 . 68	3rd Qr. 1823	4th Qr. 1823

The above Map of Township No. 26 North of Range No. 8 East of the Principal Meridian Michigan is strictly conformable to the field notes of the survey thereof on file in this Office which have been examined and approved.

Surveyor General's Office
Cincinnati, Dec. 8th 1823.

William Johnston
Sur. Gen.