


Section 21-06
 22-15

Township 1° 27' N Range 1° 6' East Mer.

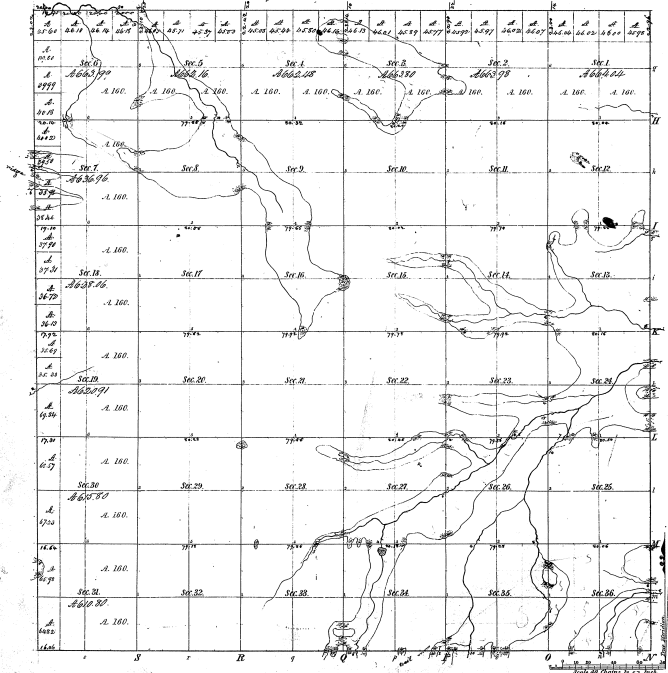

Boundaries of			
22-15			
22-15			

Survey Designated	By Whom Surveyed	Date of Contract	Amount of Survey	When Surveyed	Place for and date of the first sale
Township 1° 27' N	John A. Blaine	Jan. 19, 1850	27 sq. 1260		
22-15	John A. Blaine	Feb. 25, 1850			

The above copy of Township 1° 27' N, Range 1° 6' East of the Principal Meridian, Michigan, is hereby confirmed to the full extent of the survey thereon filed in this office, which has been examined and approved.

Surveyor General's Office

