


Township 1° 27' N. Range 3° 7' East Mer.

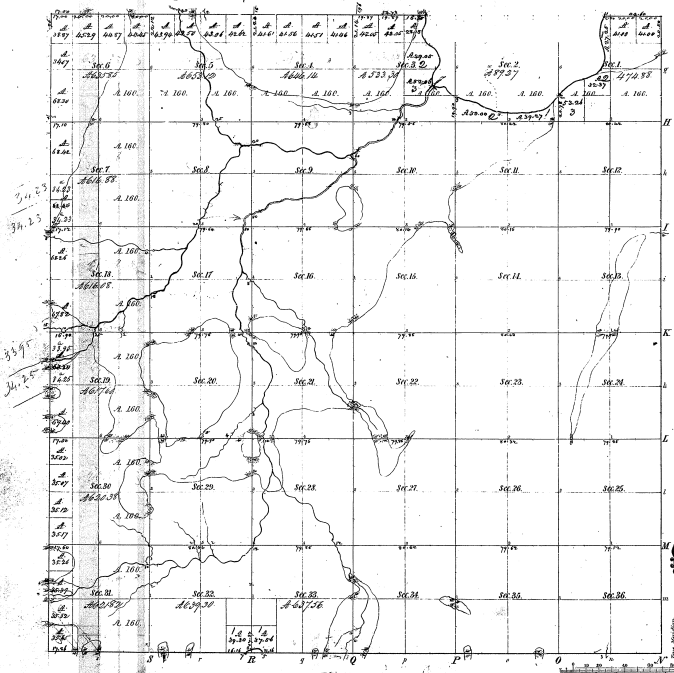

22-14
22-14




Carroll