



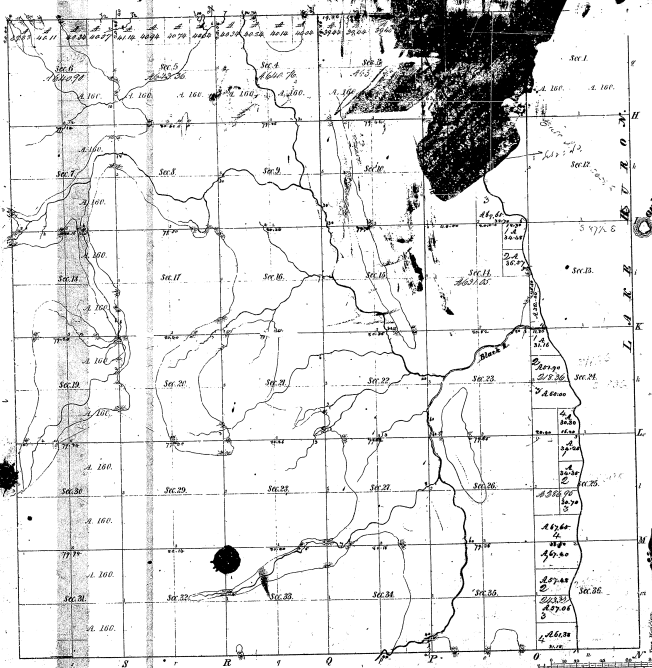



20-40







Thunder Bay Islands
 Township N° 28 N Range N° 9 E
 Mer. Mich.

20-40

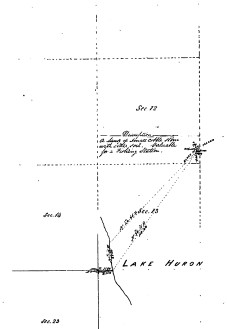







197854

MC

UNITED STATES
DEPARTMENT OF THE INTERIOR
GENERAL LAND OFFICE
WASHINGTON
FEB 19 1944

I hereby certify that the plat to attached is a photolithographic copy of the plat of survey of the lands to which it relates, on file in this office and under custody; namely:
T. 28 N., R. 9 E., Michigan Range, Michigan.

IN TESTIMONY WHEREOF I have hereunto subscribed my name and caused the seal of this office to be affixed, at the city of Washington, on the day and year above written.



W. D. Donham
Assistant Commissioner of the General Land Office.

Township N^o 28 North.

Michigan.

When Surveyed	Amount of Survey M. Ch. Lts.	Date of Contract	When pat. Examined the Sec. Exam. Act.

The above Map of Township N^o 28 North of Range N^o 9 East of the Principal Meridian, Michigan, is strictly conformable to the field notes of the survey thereof on file in this Office which have

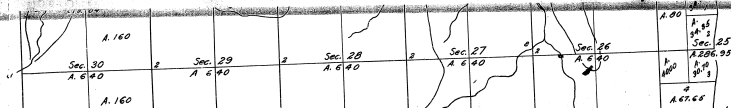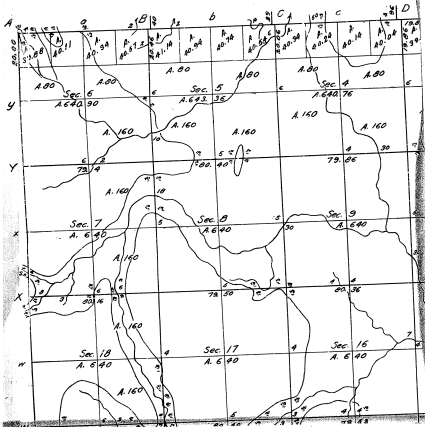


Township N^o 28 North.

Range N^o 9 East.

Michigan Meridian.

Michigan.

76-41
20-40

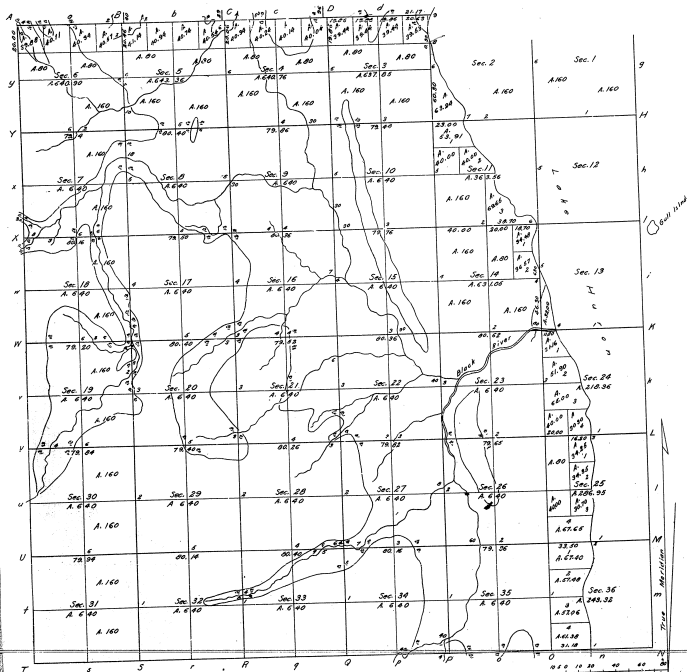

Total number of Acres, 19,121.35

Swamps Designated	By Whom Surveyed	Date of Contract	Amount of Swamps M. Chs. Lts.	When Surveyed	Where and How Made the Surveys Made
Township lines subdivisions	Levin Glenn Thos. Griffin	Mar. 1848, 1849 Feb. 1858, 1860	15. 33 .. 35 89 .. 36 .. 82	1848 1849	257 91 257 91

The above Map of Township N 28 North of
Range N 9 East of the Principal Meridian, Mich-
igan, is strictly conformable to the field notes of
the survey thereof on file in this Office which have
been examined and approved.

Surveyor General's Office,
Cincinnati, Nov. 11th, 1860.

C. S. Brown
Supt. Genl.