Reserve

Township. N.º 45 N. Range. N.º 20 W. Mer. Mich.

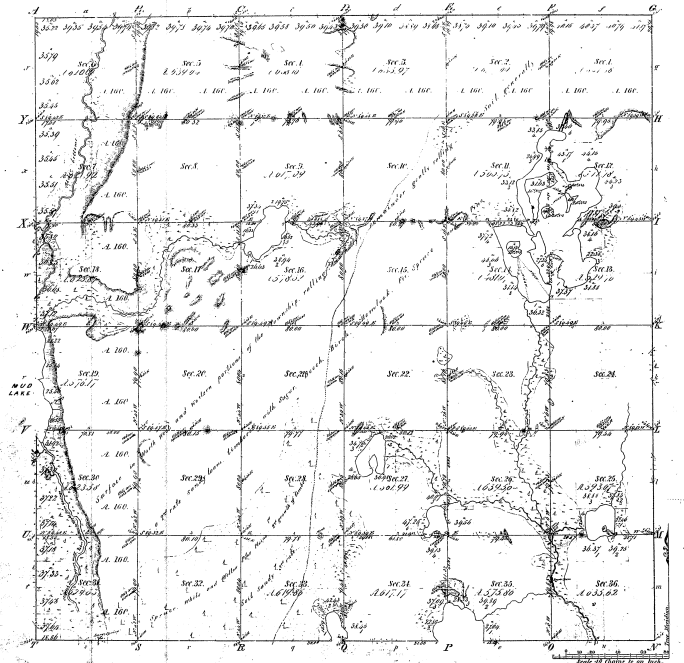

Meanders of
Prair Courses 0[illegible] Prair Courses 0[illegible] Prair Courses 0[illegible]

Meas. Lo. 13 poles 00 Lks. 1866.

Scale 40 Chains to an Inch.

Total number of Acres 22007.45

Courses Designated	To Whom Surveyed	Date of Contract	Amount of Surveys	When Surveyed	When Plats and Fd. Notes were Rec.d in the Surv.r Gen.l Office
Township Lines	W. J. Butler	April 1st 1854		2d Quar. 1854	
Subdivisions	E. H. Sopris	April 8th 1865	70. 70. 82.	2d & 3d Quar. 1855	

The above Map of Township 45 North of Range 20 West of the Principal Meridian of Michigan is strictly conformable to the field notes of the Survey thereof returned to this Office by the Deputy Surveyor.

Surveyor General's Office
Detroit April 11 1865

Surveyor General

Chief Clerk