


34-14

34-14

Township N^o 46 N. Range N^o 1 West Mer. Michigan

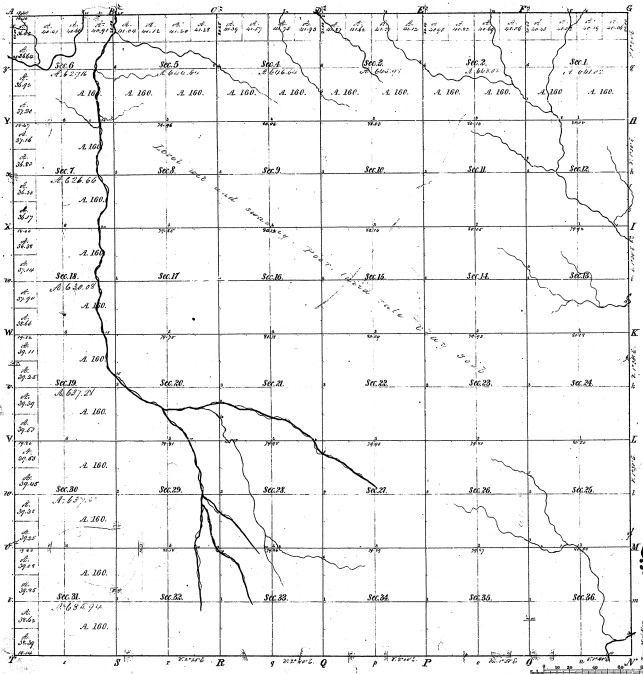

Boundaries of

Partial Course	1/2 Sec. Course	1/4 Sec. Course	1/2 Sec. Course	1/4 Sec. Course	1/2 Sec. Course
34-14					
1					

34-14

Total number of Acres 3,587.22


The above Map of Township N^o 46 North of Range N^o 1 West of the 5th Principal Meridian in Michigan was so fully examined as to the field notes of the survey thereon, as to the truth, value, accuracy and approval.

Surveyor General's Office
 Detroit, Dec^r. 11, 1855

Levin S. Lyon, Surveyor General