


Survey  

LAKE SUPERIOR

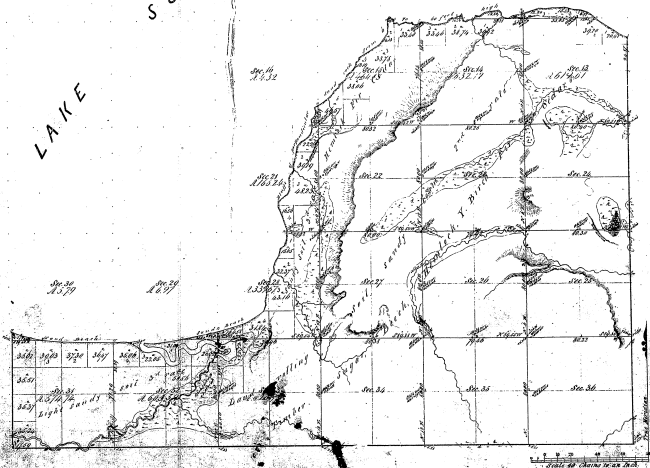

37-5

Shaded in		A1/4	1/2	3/4	A1/4	1/2	3/4
Per	Cont						
37-5							
Mention Made of Ch. 97th							

Total number of Acres 24,124

Survey	By Whom Surveyed	Date of Comm.	Number of Acres	When Surveyed	When Closed in

 Surveyor General of Michigan