


T 1 N. R. 12 W.

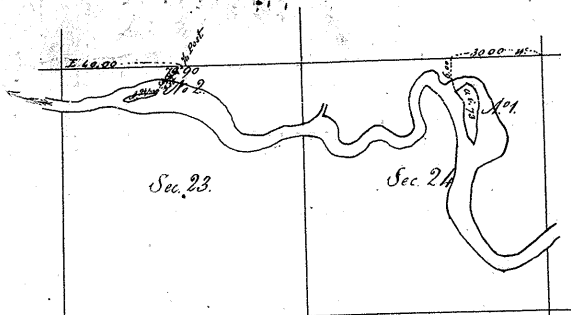

Surveyed in 1850 by Thomas Whelpley, Deputy Surveyor.

The above diagram of islands in the Kalamazoo River
in T. 1 N. R. 12 W. is strictly conformable to the field notes
of the same on file in this office.
Surveyor General's Office,
Detroit August 29 1850.

Mark Noble
Surveyor General

