



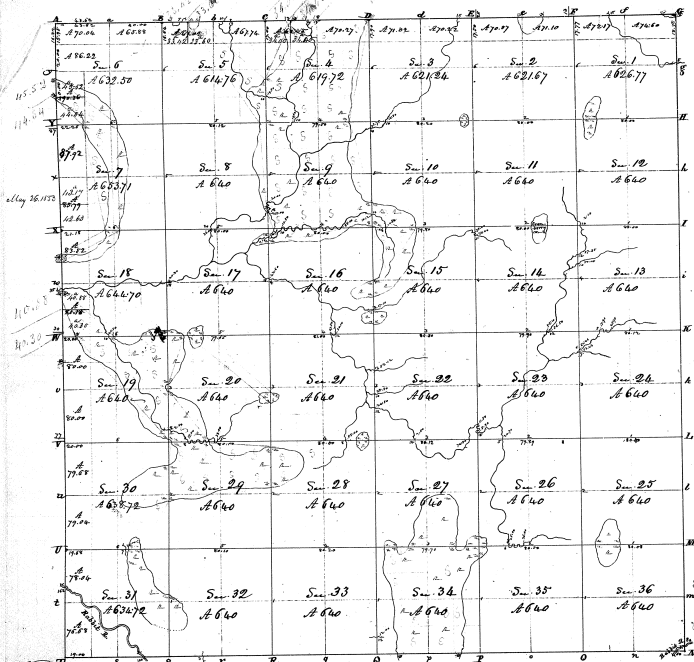

Total Contents Acres 22,968.4



George Cassels (Agent) E
 Cincinnati, Dec. 18. 1831 E
 M. T. Williams
 Surveyor General

7-25

7-25