Township N. IV, North, Range N. XIII, West Mer. (Mic. Ter.)

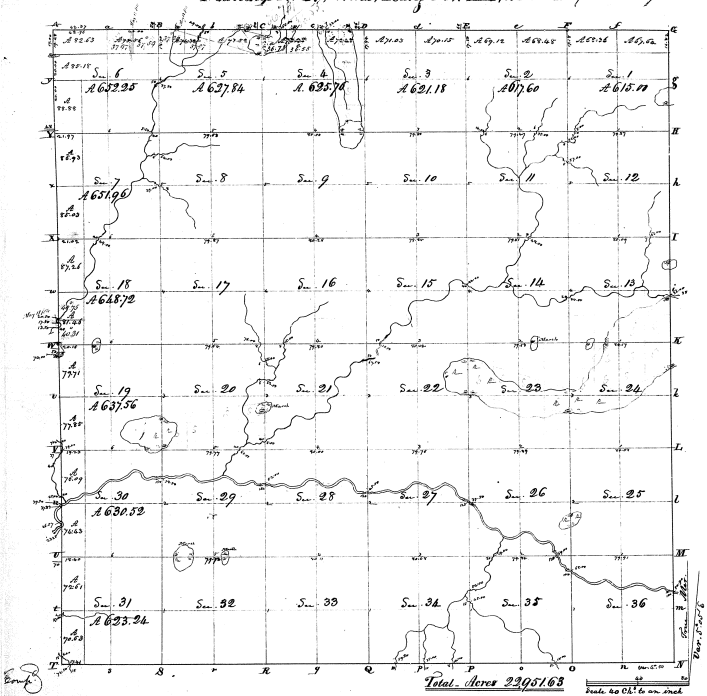

Surveys designated by	By whom surveyed	Date of Contract	Amount of Survey M. C. L.	When Surveyed	When p.d. for 1 ch. in Sinc. Gen. Acc.
S.W.P. boundaries	L. Lyon	25. Aug. 1830		2 y. 1831	4. y. 1831
N.W.P. "	Same	" " "		4 " "	1 y. 1832
Subdivisions	Same	" " "	59.70.42	" " "	" " "

The above map of Township N. 4 N. of Range N. 13 W. of the Principal Meridian, Territory of Michigan, is strictly conformable to the field note of the survey thereof, on file in this office, which have been examined and approved.

Surveyor General's Office
Cincinnati, March 6th 1832

M. F. Williams
Sur. Genl.

Contents

Sections	Acres	Wd.	Sections	Acres	Wd.

8-28