


Township N. IV North, Range N. XV West Mr. (Mic. Tor.

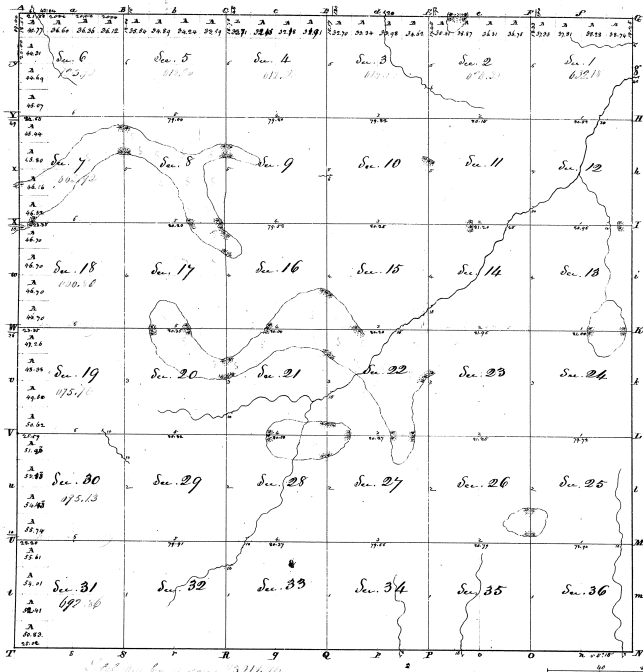

8-26

8-26

Survey description	By whom surveyed	Date of survey	Acres	Section
Remainder	L. Egan	12. Nov 1830	66.6	27
Subdivision	C. Britton	R. 60.0977	2.7	1833

The above allot of Township N. IV North, of Range N. XV West of the Meridian, which you have is fully conformable to all field notes of the Surveyors, to file in this Office, which have been examined, and approved.
 Witness General's Office
 Washington 4th 6 1833
 N. T. Nelson
 Sec Gen.