


Re Survey of  
 Township 1<sup>st</sup> 2N. Range 1<sup>st</sup> 8 W. Mer. Mich.

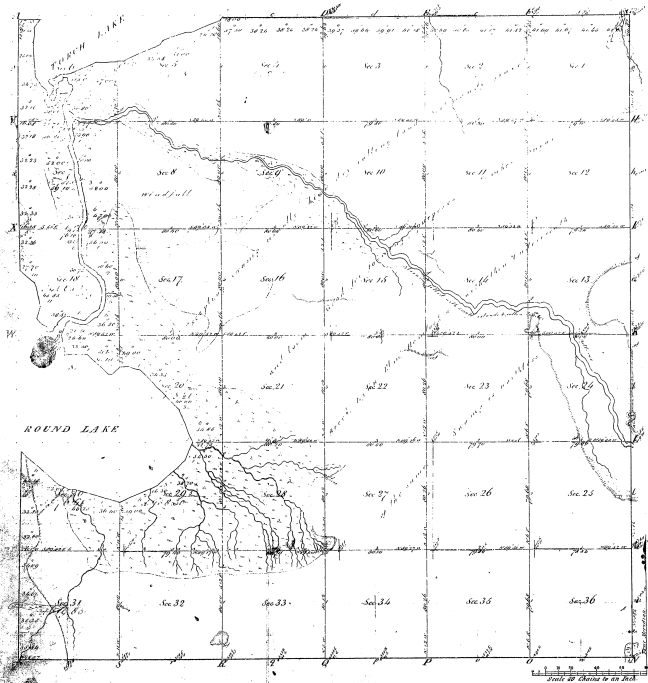

Boundaries of  

--	--	--	--

Note: The blue figures and marks show the portions of the old corners and lines.

Measured 10 m. Sec. 26

15-9

Total number of Acres 2140 264

Survey completed by whom Surveyed day of month	Amount of Survey in Acres	When Surveyed	When Closed on the Survey


Surveyor General's Office,  
 Detroit Mich. 20<sup>th</sup> Dec. 1851

A. C. Smith  
 Notary Public