


 Township N^o 28 N. Range N^o 9 W. Mer. 10th.

Grand Traverse Bay

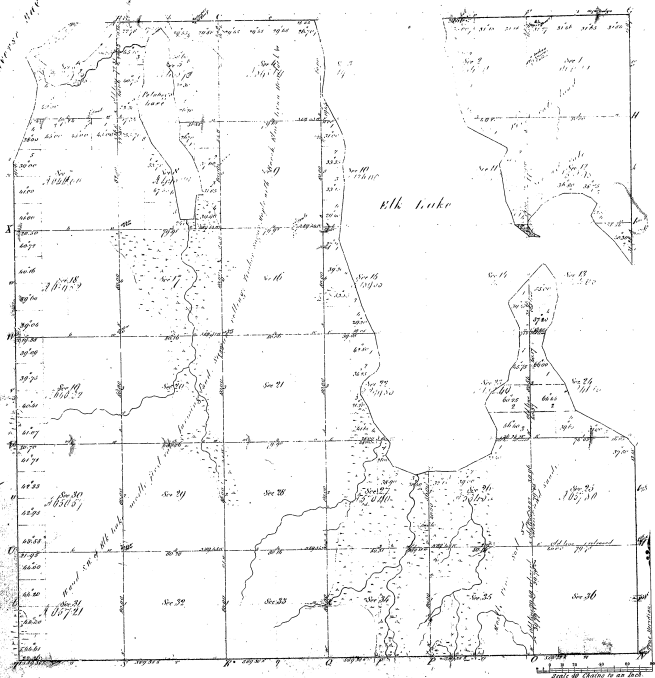

12	16-13
----	-------

Total number of acres 1,560.56


The above Map of Township N^o 28 North of Range N^o 9 West of the Principal Meridian Michigan is a truly correct & the full set of the survey being on file at the office of the Surveyor General of Michigan.

Surveyor General's Office Charles K. Ketchum Secy. Genl.
 Detroit, Dec. 11, 1855