Township N.º 29 N., Range N.º 6 West Mer: (Mich.)

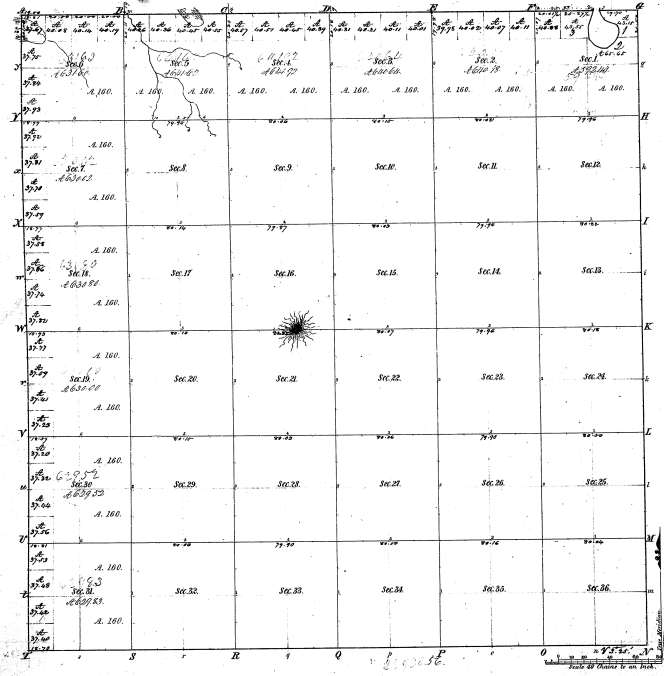

Meanders of part of a Lake in Section 1

Posts	Courses	Ch. Lks.	Posts	Courses	Ch. Lks.	Posts	Courses	Ch. Lks.
1	N 22½ E	8.00						
	N 74½ E	11.50						
	N 33½ E	8.00						
	N 44½ W	16.33						
	N 89½ W	9.00						
	N 53½ W	9.00						
	North	15.33						
2	N 22½ E	11.50						

Total number of Acres 22,938.56

Surveys Designated	By Whom Surveyed	Date of Contract	Amount of Surveys	When Surveyed	When 1st or 2nd or 3rd or 4th Sect. Cor. Posted
Township lines	James McMullen	July 18. 1839	M. 96 Ch. 17 77 70	3rd Qr. 1839	
Subdivisions	[illegible]				
N. Boundary	[illegible]	July 26. 1839	6. 00. 00	3rd Qr. 1839	

The above Map of Township No. 29 North of Range No. 6 West of the Principal Meridian Michigan is strictly conformable to the field notes of the surveys thereof on file in this Office, which have been examined and approved.

Surveyor Generals Office, Cincinnati, Nov. 18th 1839

Surv. Genl.

15-6