


Resurvey
Township N^o 31. E. Range N^o 8 W. Men. Mich.

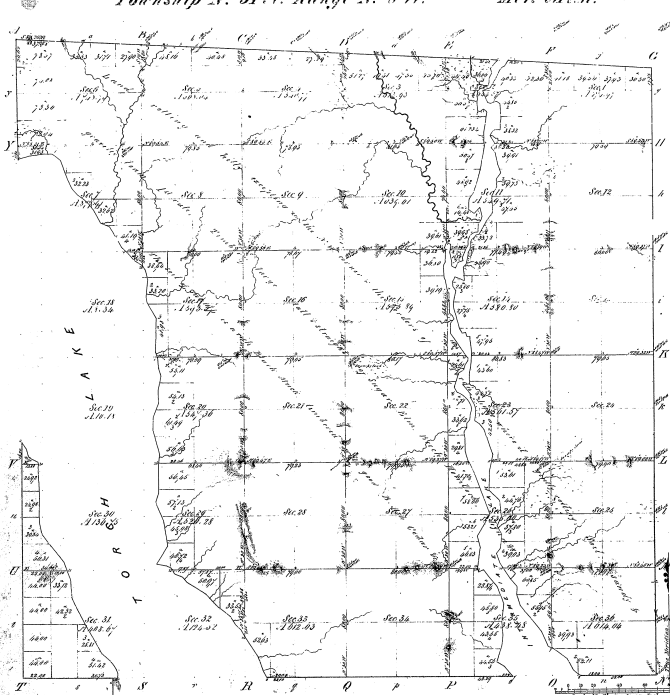

1531
18-31

Total number of Acres 1134.66

Survey Designated.	By Whom Surveyed.	Date of Contract.	Amount of Survey in Acres	When Surveyed.	When Closed in the Survey
Township Survey, 31. E. 31. N.	John Hoffman	Dec. 14 th 1855	8, 000 000	1855	1855
1/2 Sec. 30, Township	J. C. D. Brewster	April 22, 1858	11, 765 55	1858	1858
Subdivisions	Sec. 31, 32, 33, 34, 35, 36	April 12, 1858	73, 65 66	1858	1858

The above Map of Township N^o 31. E. Range N^o 8 W. West of the Principal Meridian of Michigan is partly conformable to the field notes of the survey thereof from the office of the Surveyor General and approved.

Surveyor General Office
St Paul July 1858
Geo. E. Lawrence Sur. Genl.
Geo. W. P. Cook