Resurvey

Township No. 32 N. Range No. 8 W. Mer. Mich.

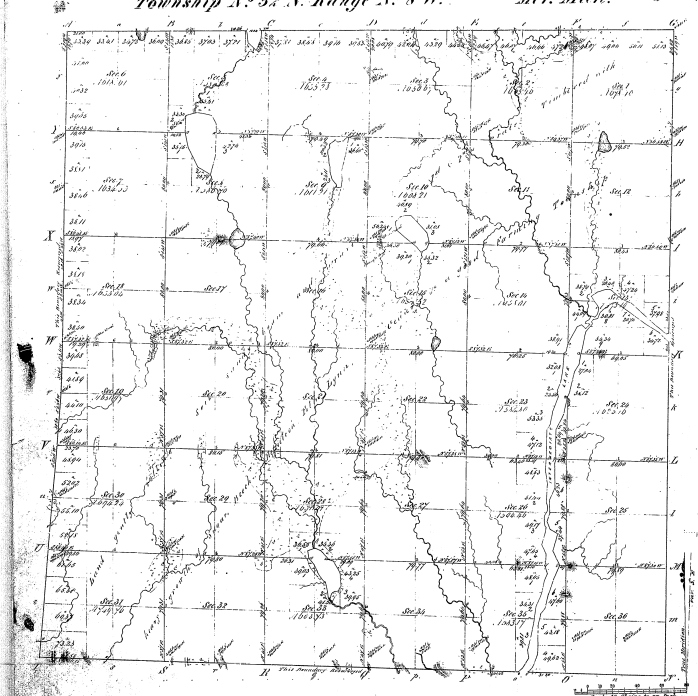

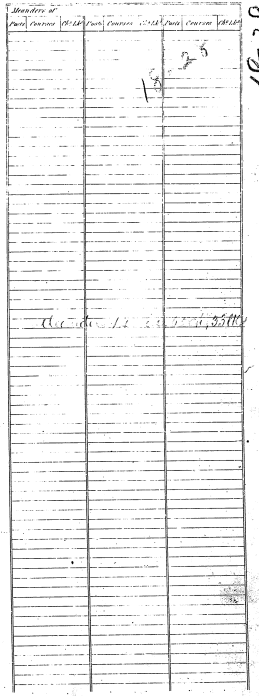

18-28

Total number of Acres 22765.01

Surveyed.	By Whom Surveyed.	Date of Contract	Amount of Surveying			When Surveyed.	When Changed to the Surveyed as at
			M.	Chs	Lks		
Exterior	A. D. Atwater		12	23	40	2nd Quarter 1847	
Subdivisions	A. D. Atwater	Special 1st inst.	43	22	33	2nd Quarter 1847	

The above Map of Township 32 North of Range 8 West of the Principal Meridian of Michigan is strictly conformable to the field notes of the survey thereof on file in this Office which have been examined and approved.

Surveyor Generals Office
St. Louis Septr 5th 1849

O. L. Hamsom Surv. Gen.