Re Survey

Township N°19 N. Range N°4 East Mer. (Michi.)

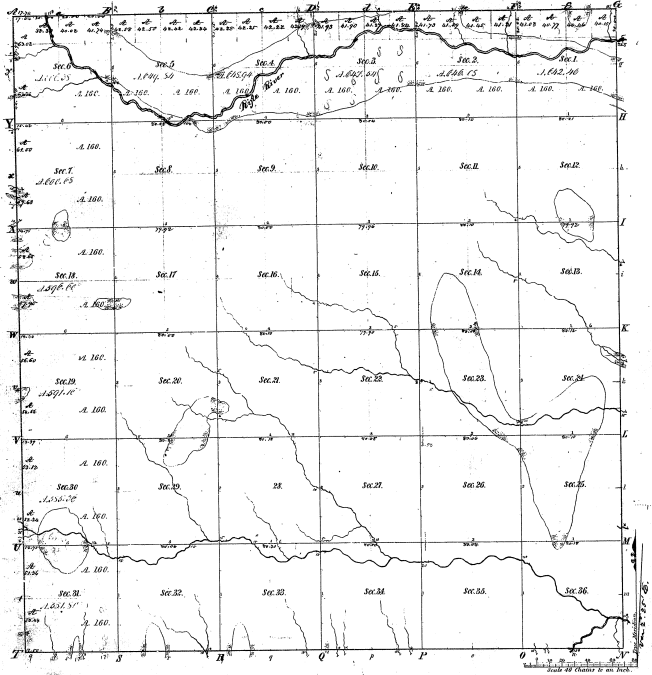

Meander of

Posts	Courses	Dist.	Posts	Courses	Dist.	Posts

Total number of Acres 22,796.84

Surveys Designated	By Whom Surveyed.	Date of Contract	Amount of Surveys	When Surveyed	When Plat of and returned to the Surr Gen.l's Office	When Approved
Township Lines	Darius Abbott	April 1st 1824	78 03 Mr.	4th Sept. 1824	4th Sept. 1824	4th Sept. 1824
Subdivisions	John Knaggs	May 27. 1824	59.85.57	25th Sept. 1826	4th Sept. 1842	

The above Map of Township N°19 North of Range N°4 East of the Principal Meridian Michigan is strictly conformable to the field notes of the Survey thereof on file in this Office which have been examined and approved.

Surveyor Generals Office
Cincinnati, Nov. 6th 1843

William Johnston
Surr Gen.l

33-8-3