


Re-Survey
Township N^o 29 N. Range N^o 5 East Mer. (Mich.)

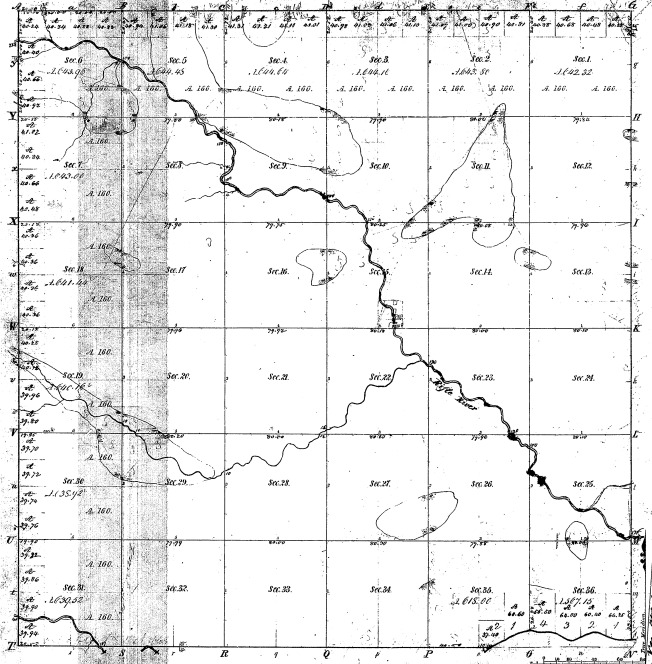

Registers of Township Survey




Total number of Acres 22,077.55


