Re Survey

Township N.º 20 N. Range N.º 4 E. Mer. Mich.

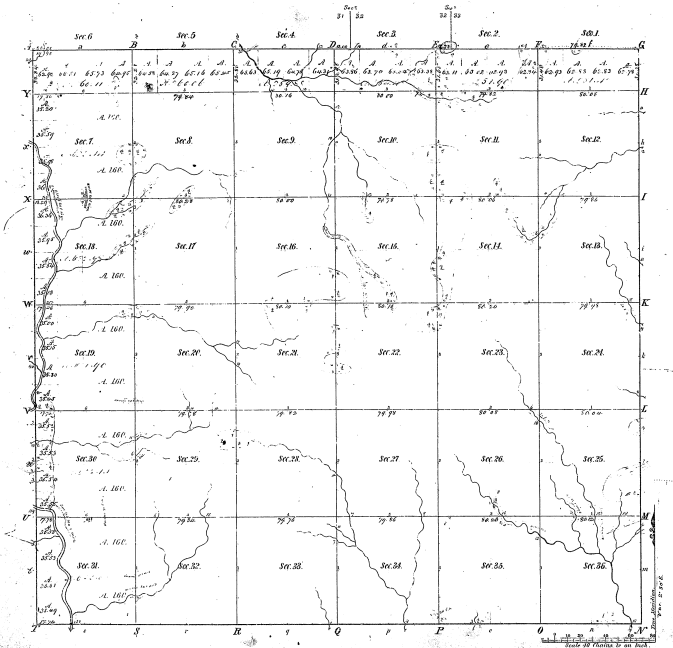

Meanders of

Posts	Courses	Dist.s	Posts	Courses	Dist.s	Posts	Courses	Dist.s

Total number of Acres 20047.64

Surveys Designated	By Whom Surveyed	Date of Contract	Amount of Surveys	When Surveyed	Whether the said Surveys are approved or not
Original Survey	Alvah Mallett	June 7th 1824	M. Chs. Lks. 22 [illegible]	[illegible]	
Subdivision	Alvah Mallett	June 7th 1824	22 80 00	[illegible]	

The above Map of Township No 20 North of Range No 4 East of the Principal Meridian Michigan is hereby conformable to the field notes of the Survey thereof in the Surveyor Generals Office which have been examined and approved.

[illegible]