


Township 47th N. Range 33rd W. Mer. 11th Ch.

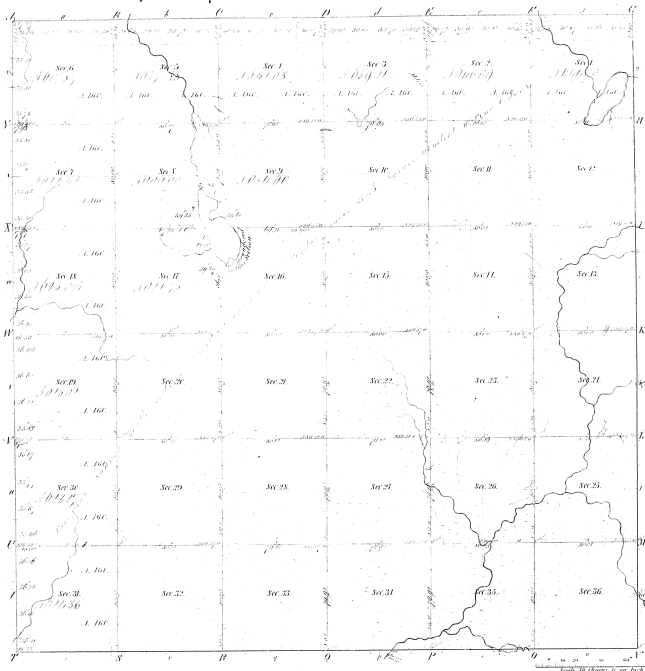

Total number of Acres 22,283.79


The above map of Township 47th North Range 33rd West of the Principal Meridian Michigan is hereby returned to the field notes of the survey thereon filed on this day, which have been examined and approved.



